

Name **Arthur Bryson**

Service No. **184**

Address **41 Fair Oaks Drive**

Location

Kind of Pipe

Size

Size of Main

~~REPAIR EXISTING~~ **New Service**

Location

Corner 12-14-59

Date	Material	Amount	Total	Date	Amount
-6-59	Labor	29.00		<i>9-23-59</i>	<i>Deposit</i>
-7-59	"	73.49		<i>1-19-60</i>	<i>Paid</i>
-8-59	"	37.04	139.53		<i>248.62</i>
	10% O.H.	13.95	153.48		
	56' 6" Transite pipe @.70		39.20		
	25 Sticks Dynamite @.26		6.50		
	14 Blasting Caps @.28		3.92		
	1 6" Transite Elbow 45°		2.79		
	2 11 1/2" Elbows @2.24		4.48		
	6 X 3 Patch		6.00		
	5 hrs. Pippin @4.50		22.50		
	5 hrs. Trucking @.75		3.75		
	2 hrs. Compressor @3.00		6.00		
			<u>248.62</u>		


DATE _____

TOWN OF LEXINGTON — BOARD OF PUBLIC WORKS

SEWER DIVISION

Sketch of Service Here

41

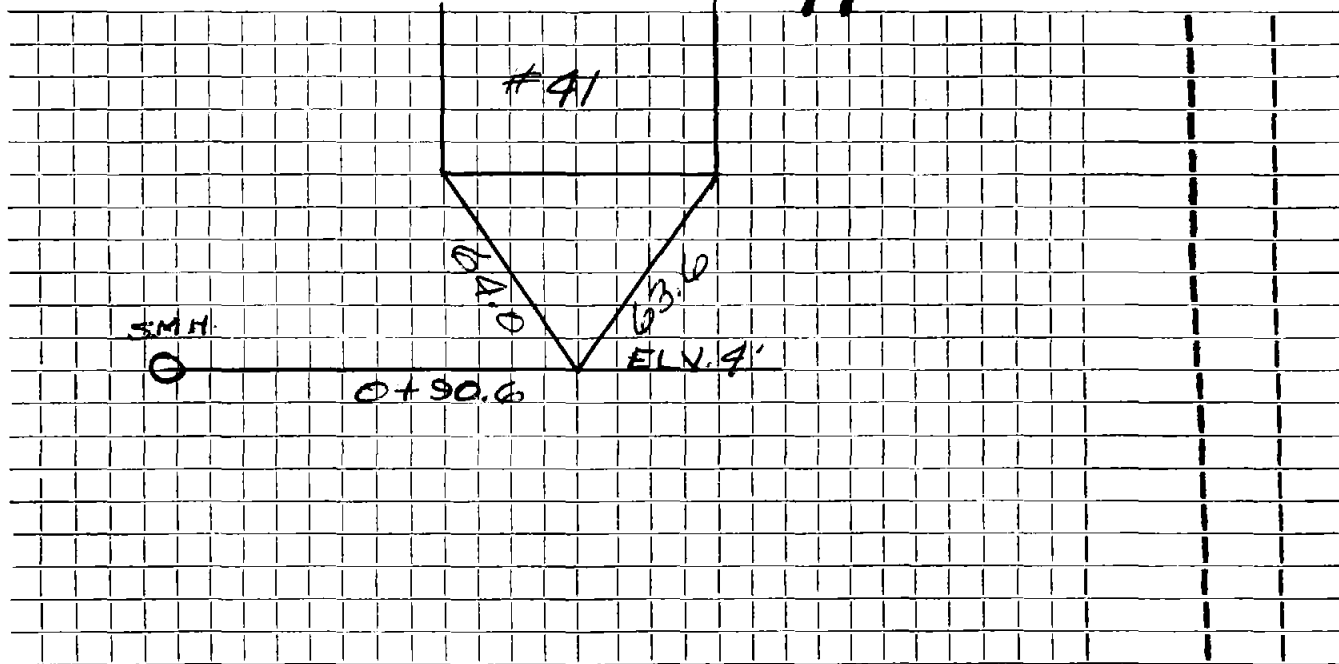

Connection made in Street. Work completed

Remarks:

.....

.....