

Name

Service No.

Address 15 FAIR OAKS TERRACE

Location

Kind of Pipe

Size

Size of Main

Repair—Renewal—New Service

Location

Date

Material

Amount

Total

Date

Amount

10/19 83

24LF 6" PVC


384 00

DATE \_\_\_\_\_

TOWN OF LEXINGTON — BOARD OF PUBLIC WORKS  
SEWER DIVISION

Sketch of Service Here

15

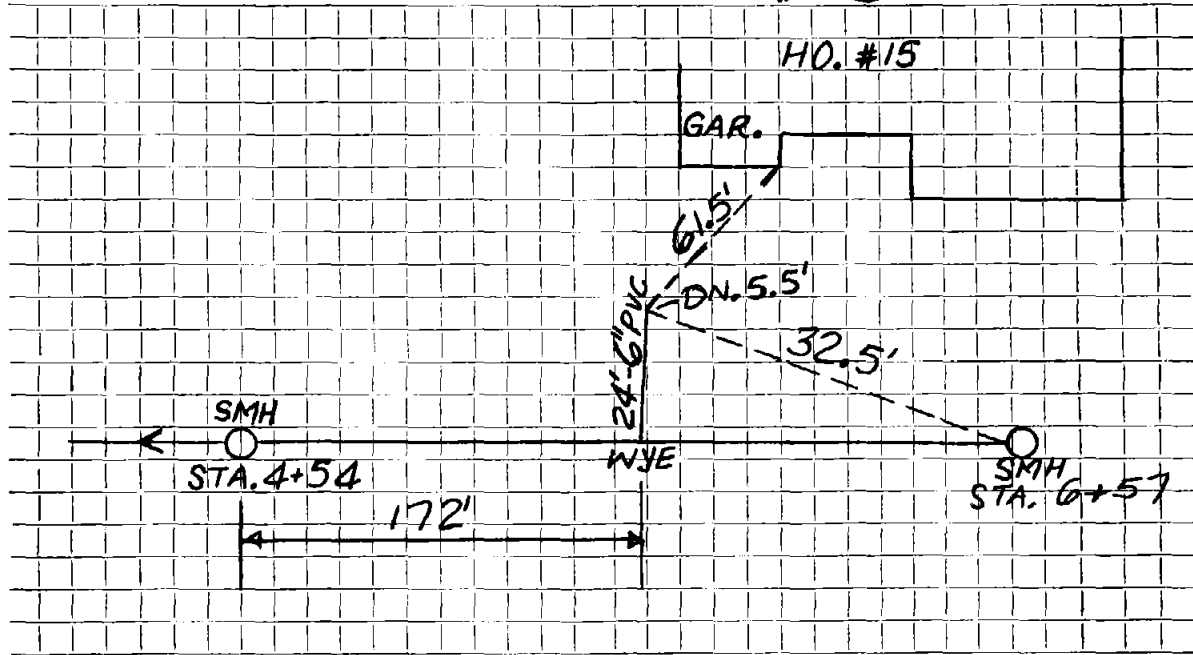

Connection made in FAIR OAKS TERRACE Street. Work completed .....

Remarks: .....  
.....  
.....