


DATE 7/10/92

TOWN OF LEXINGTON — BOARD OF PUBLIC WORKS

SEWER DIVISION

Sketch of Service Here **16**

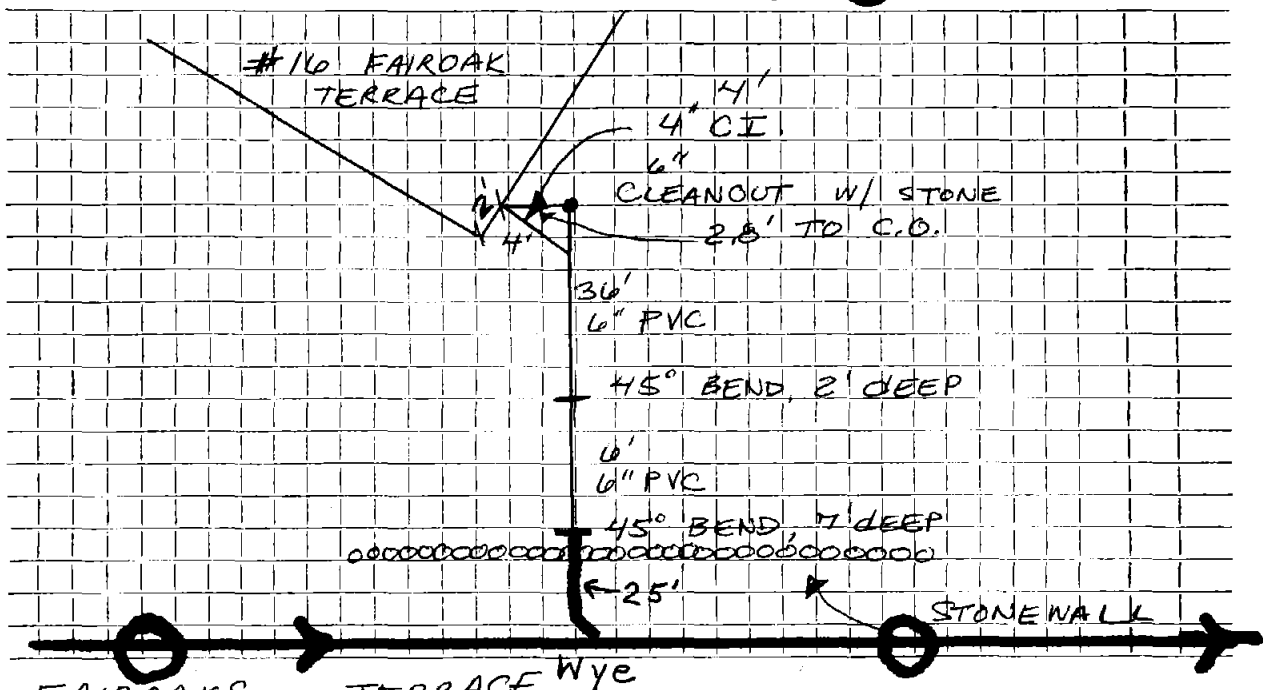

Connection made in FAIROAKS TERRACE Work completed

Remarks: