




DATE \_\_\_\_\_

TOWN OF LEXINGTON — BOARD OF PUBLIC WORKS

SEWER DIVISION

Sketch of Service Here

18

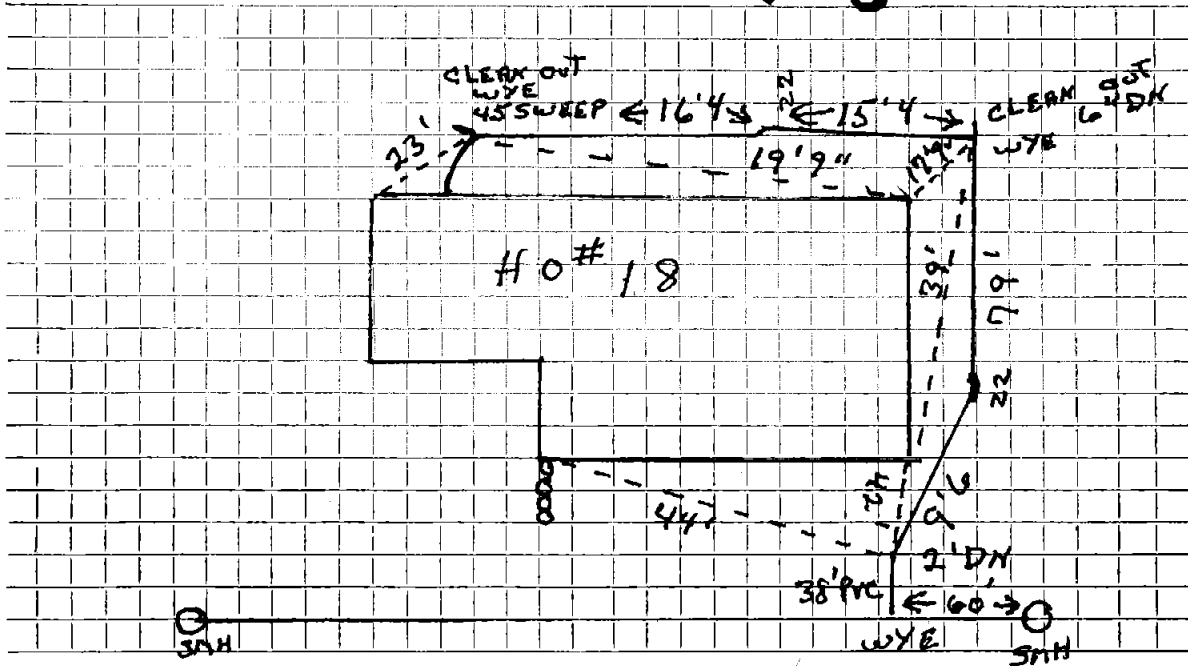

Connection made in FAIRBANKS TERR. Street. Work completed .....

Remarks: .....  
.....  
.....