

Name *William L Potter*

Service No.

Address *21 FAIR OAKS*

Location

Kind of Pipe

Size

Size of Main

Repair—Renewal—New Service *Arlex # 0257*

Location


Date	Material	Amount	Total	Date	Amount
<i>8/7/93</i>	<i>7 LF 4" CI</i>			<i>7-7-93</i>	<i>Paid</i>
	<i>89 LF 6" PVC</i>				
	<i>2-22° ELBOWS</i>				
	<i>2-45° ELBOWS</i>			<i>10-18-83</i>	
	<i>6"X6" FERNCO</i>			<i>43' 6" P.V.C.</i>	
	<i>4"X6" FERNCO</i>				
	<i>6"X6" WYE CLEAN-</i>				
<i>10-18-83</i>	<i>4" 6" FERNCO ^{OUT}</i>		<i>688.00</i>		

DATE 1/5/94

TOWN OF LEXINGTON — BOARD OF PUBLIC WORKS
SEWER DIVISION

Sketch of Service Here

21

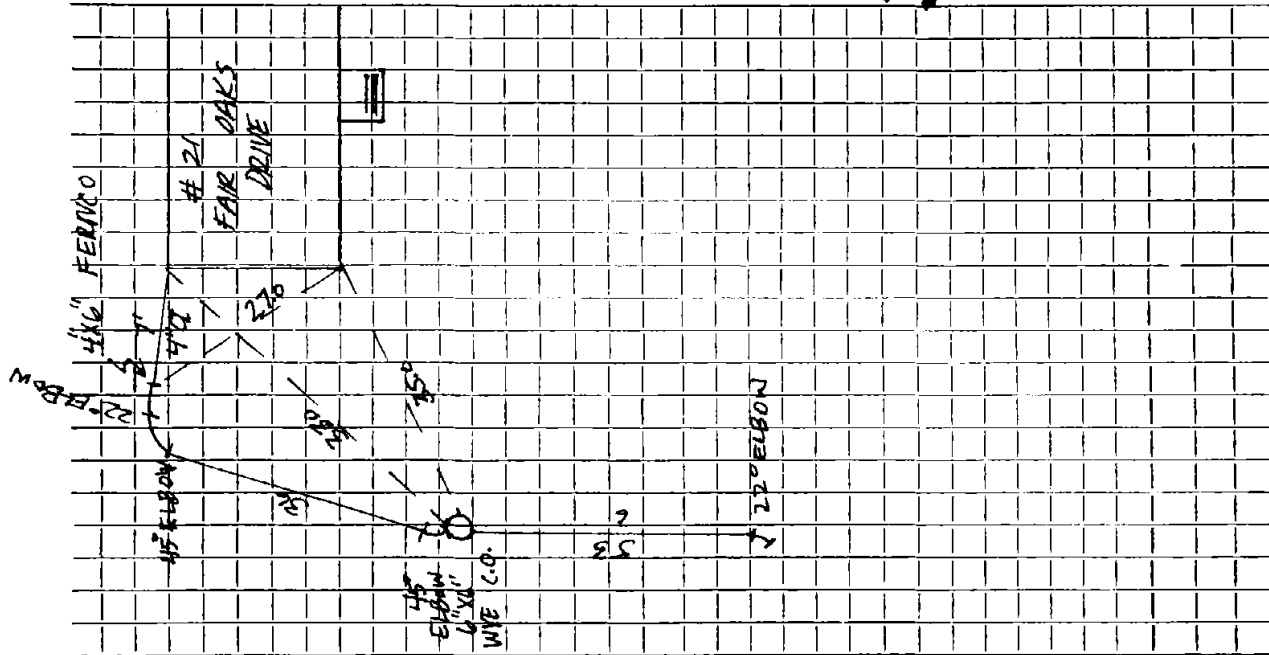

Connection made in Street.

Work completed 8/7/93 .. ARLEX OIL CORP. ..

Remarks:
.....
.....