


DATE 12/1/83

TOWN OF LEXINGTON — BOARD OF PUBLIC WORKS
SEWER DIVISION

Sketch of Service Here **22**

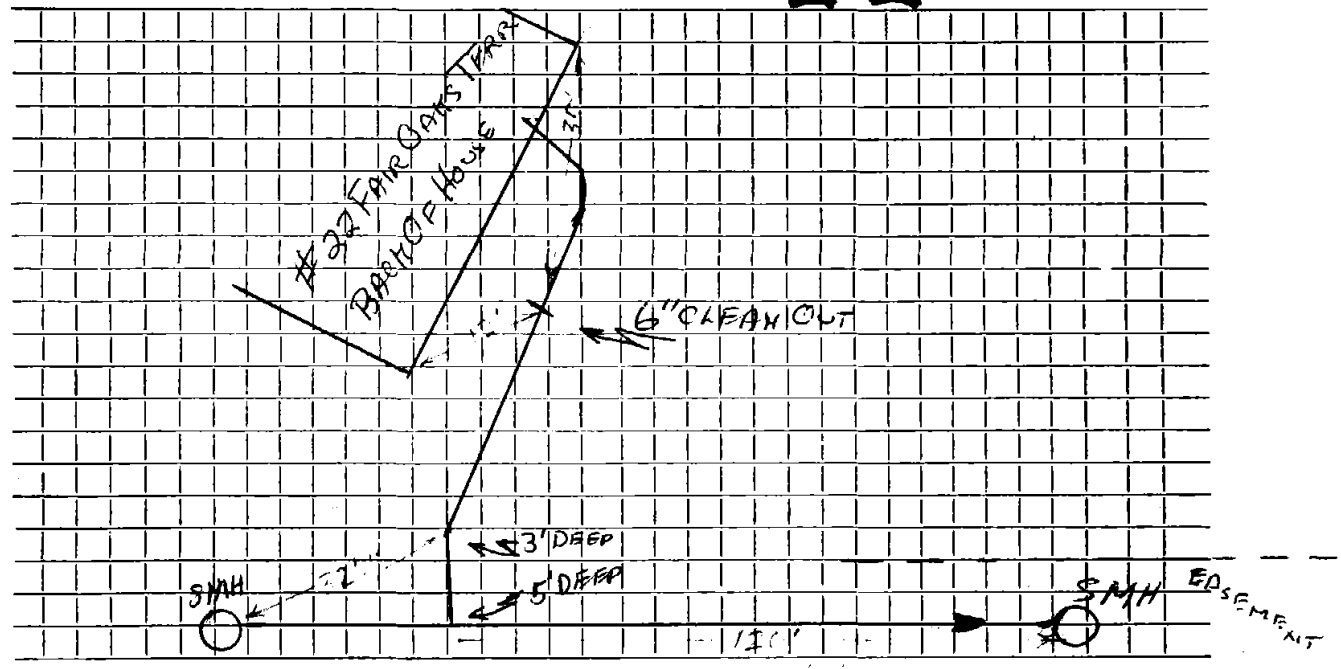

Connection made in EASEMENT Street. Work completed MARCH 1984

Remarks: