


DATE Nov 8, 1985

TOWN OF LEXINGTON — BOARD OF PUBLIC WORKS
SEWER DIVISION

Sketch of Service Here

24

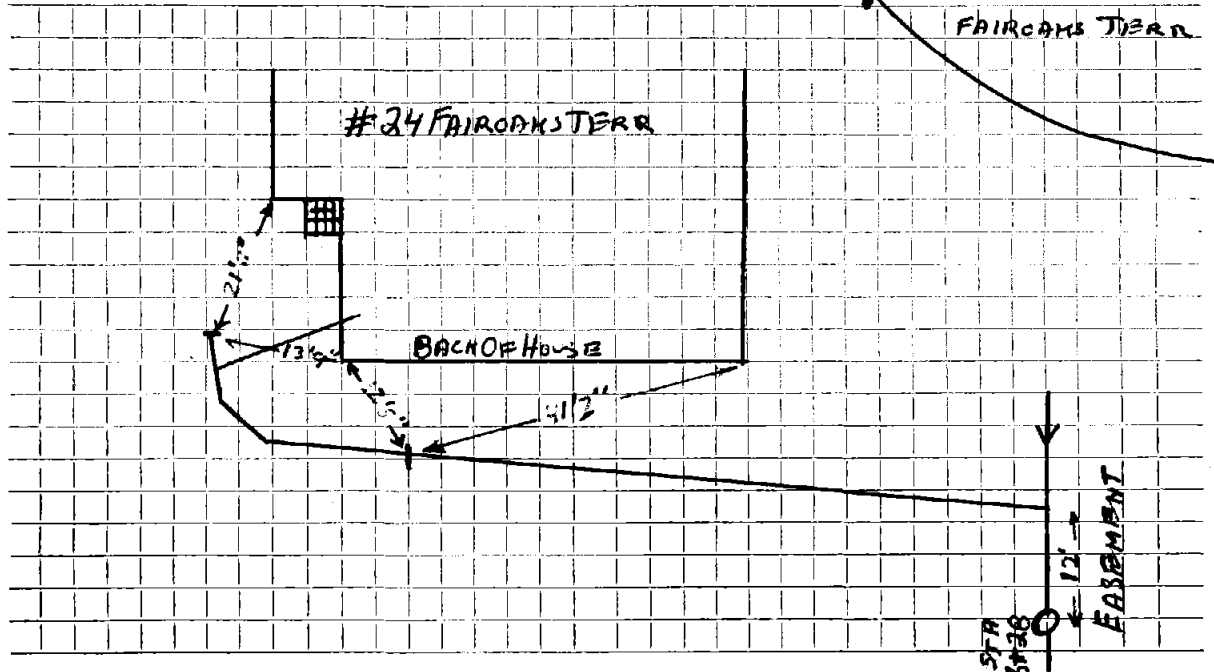

Connection made in EASEMENT OFF FAIROAKS TERR. Street.

Work completed Nov. 1985

Remarks:

.....

.....