

Name Robert S. Wiener

Service No. 187

Address 6 Fair Oaks Terrace

Location

Kind of Pipe

Size

Size of Main

~~Repair Service~~ New Service

Location *Comm 12-14-59*


Date	Material	Amount	Total	Date	Amount
5-59	Labor	33.83		9-13-59	200 00
6-59	"	39.86	73.69	12-14-59	50 97
	10% O. H.	7.37	81.06		149 03
	46' 6" Transite pipe @.70		32.20		
	8 Sticks Dynamite @.26		2.08		
	5 Blasting Caps @.28		1.40		
	1 6" 900 Transite Elbow		5.29		
	2 hrs. Compressor @3.00		6.00		
	3 hrs. Pippin @4.50		13.50		
	2 hrs. Trucking @.75		1.50		
	6 X 3 Patch		6.00		
			149.03		

DATE _____

TOWN OF LEXINGTON — BOARD OF PUBLIC WORKS

SEWER DIVISION

Sketch of Service Here

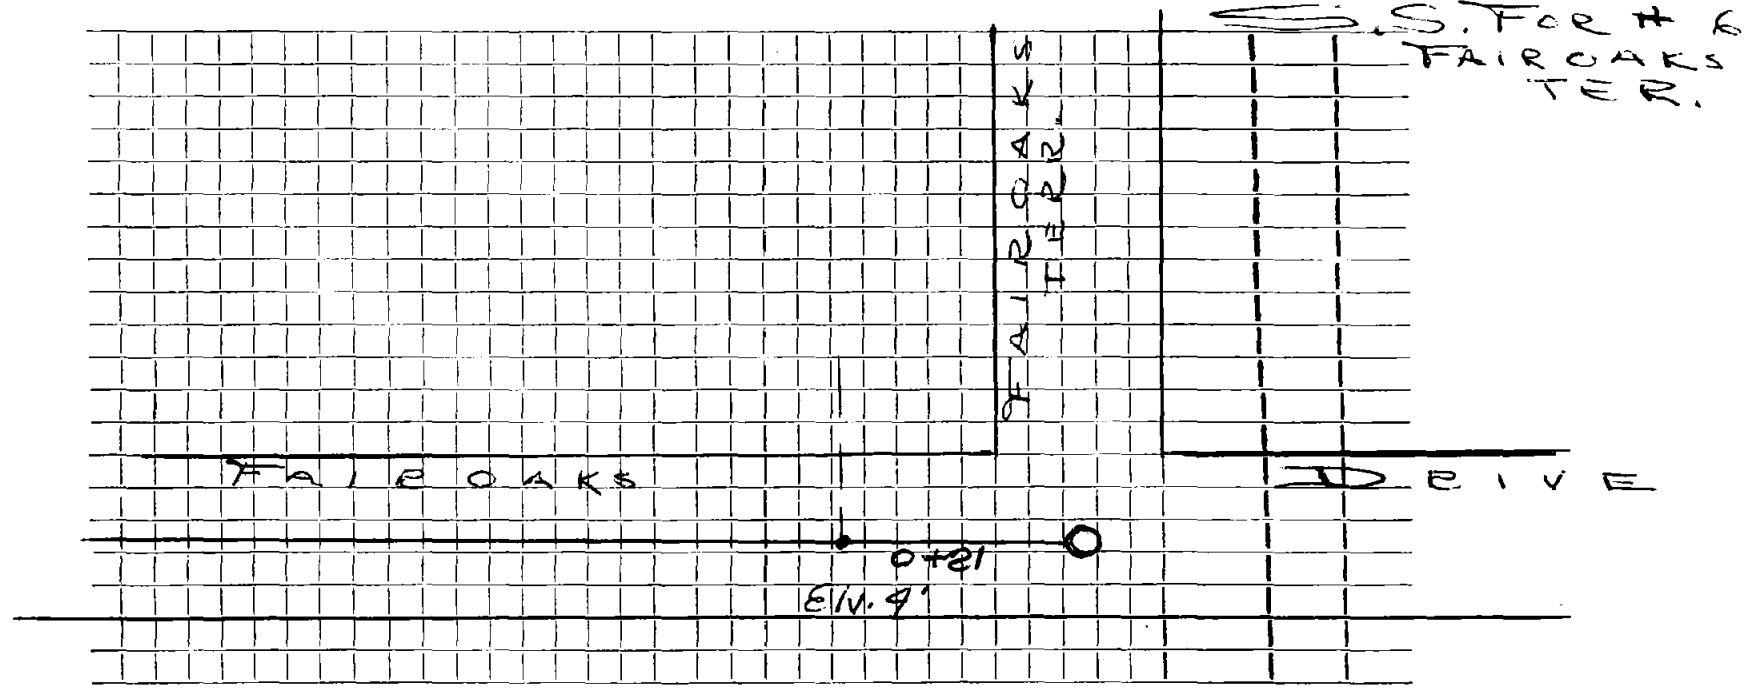

Connection made in Street. Work completed

Remarks:
.....
.....