


DATE 9/28/89

TOWN OF LEXINGTON — BOARD OF PUBLIC WORKS
SEWER DIVISION

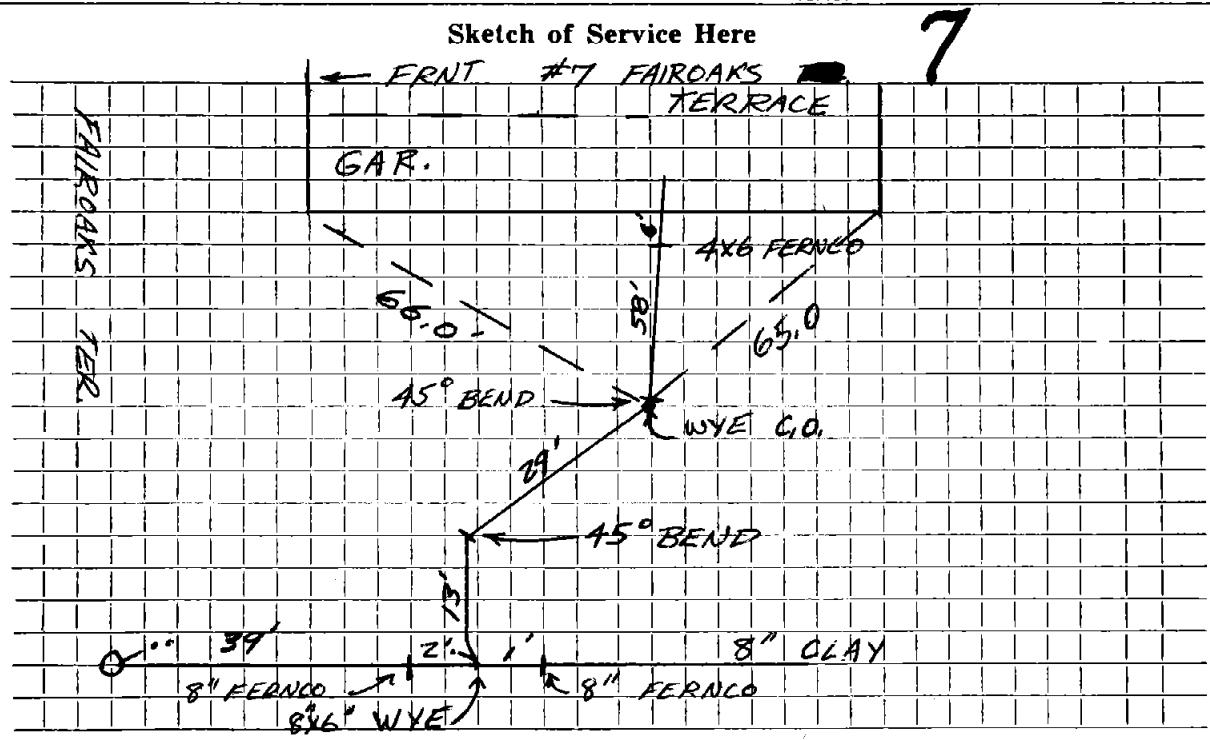

Connection made in FAIROAKS... DR. Street. Work completed

Remarks: INSP. CRG.