

Name

Service No.

Address

FAIR OAKS TERRACE (M. 33 L. 206)

Location

Kind of Pipe

Size

Size of Main

Repair—Renewal—New Service

Location

Date

Material

Amount

Total

Date


Amount

10-19 83 47 LF 6" PVC 752 00

DATE _____

TOWN OF LEXINGTON — BOARD OF PUBLIC WORKS
SEWER DIVISION

Sketch of Service Here

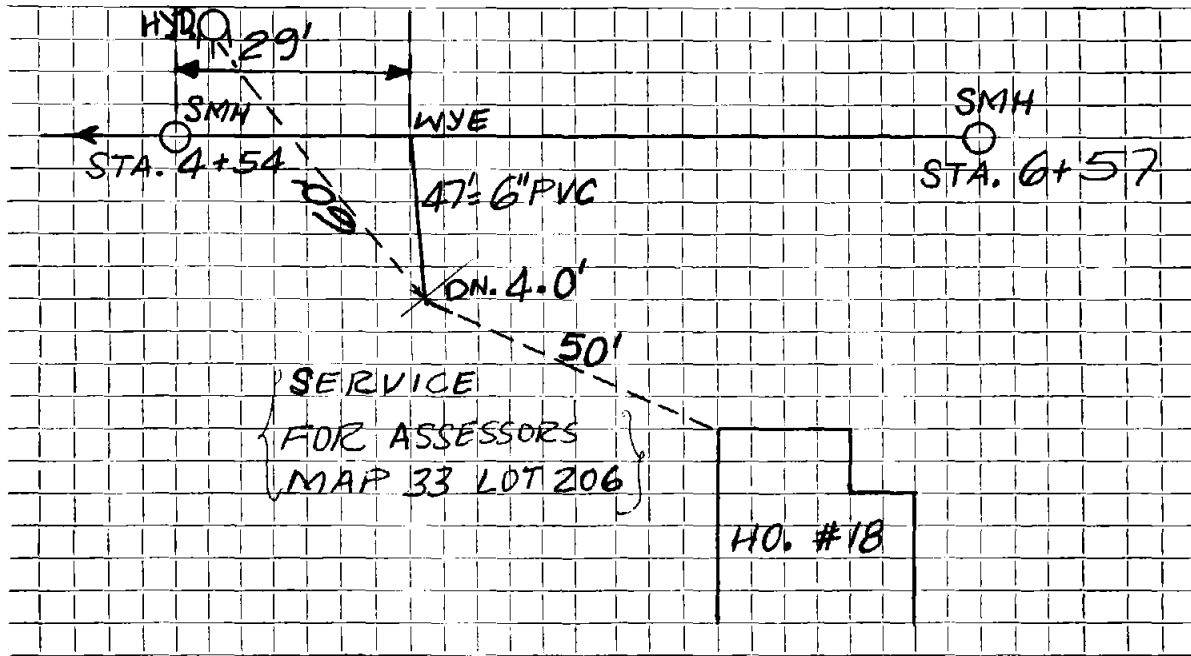

Connection made in FAIR OAKS TERRACE Street.

Work completed

Remarks:

.....

.....