


DATE _____

TOWN OF LEXINGTON — BOARD OF PUBLIC WORKS
SEWER DIVISION

Sketch of Service Here

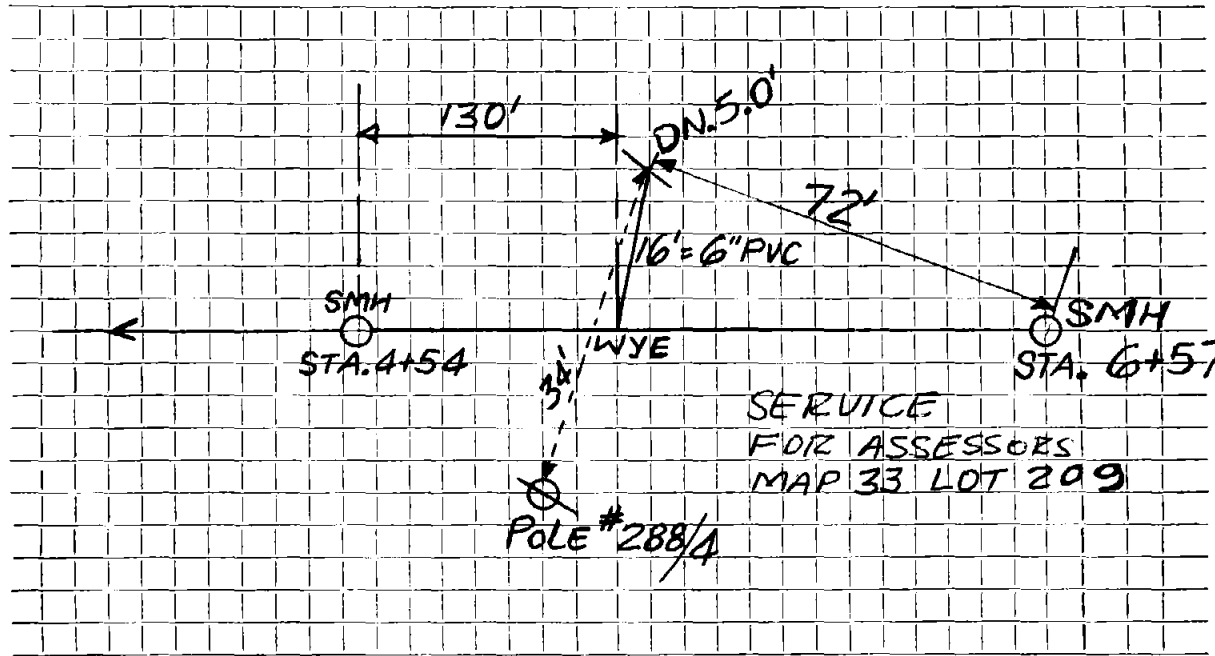

Connection made in FAIR OAKS TERRACE Street. Work completed

Remarks:
.....
.....