




DATE 12/17/2018

TOWN OF LEXINGTON — BOARD OF PUBLIC WORKS  
SEWER DIVISION

Sketch of Service Here

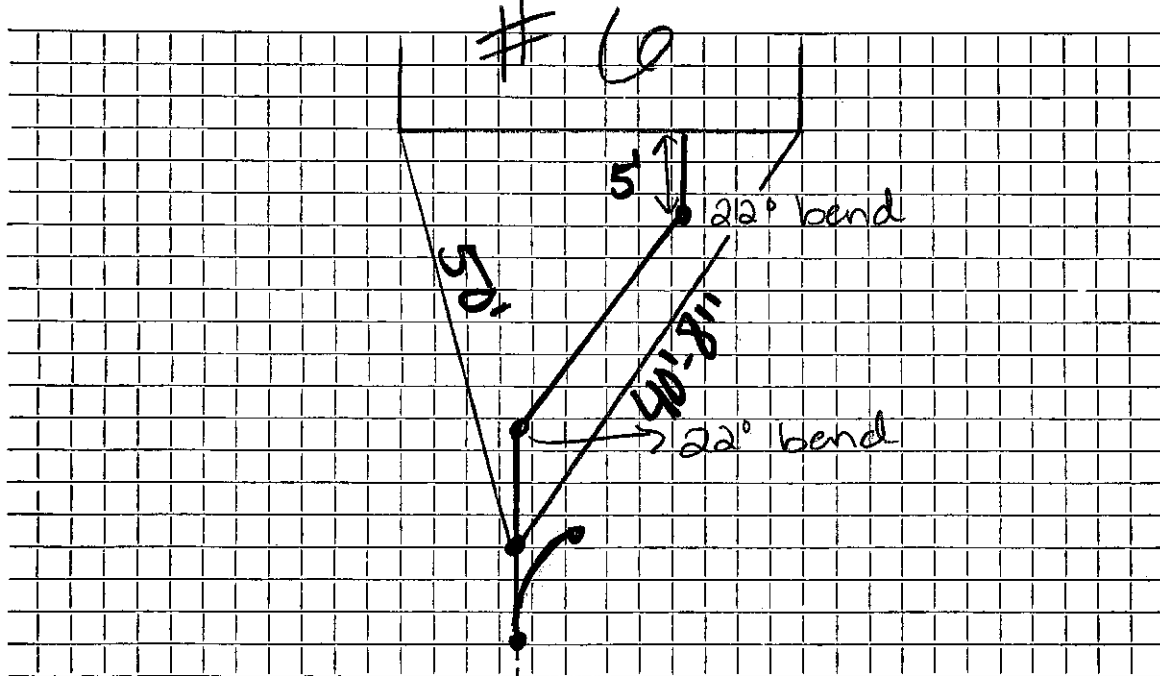

Connection made in Fairbanks Rd Street. Work completed.....

Remarks: Spot Repair