

Name

Service No. 1899

Address

~~67 SHADE ST~~

Charge #

1 Fairbanks RD

Location

Kind of Pipe

PVC

Size

6"

Size of Main

8"

Repair—Renewal—New Service

Terence J. McLaughlin

Location


Date	Material	Amount	Total	Date	Amount
9/28/05	6' 4" PVC 5/4 40				
	38' 6" PVC				
	1 4X6 FENCE				
	1 6" AC X PVC FENCE				
7/6/64	EXISTING A.C. PIPE				
	5.0 CHIM. 4.5 DWN				
	1 90° ELBOW A.C.				

DATE \_\_\_\_\_

TOWN OF LEXINGTON — BOARD OF PUBLIC WORKS

SEWER DIVISION

Sketch of Service Here

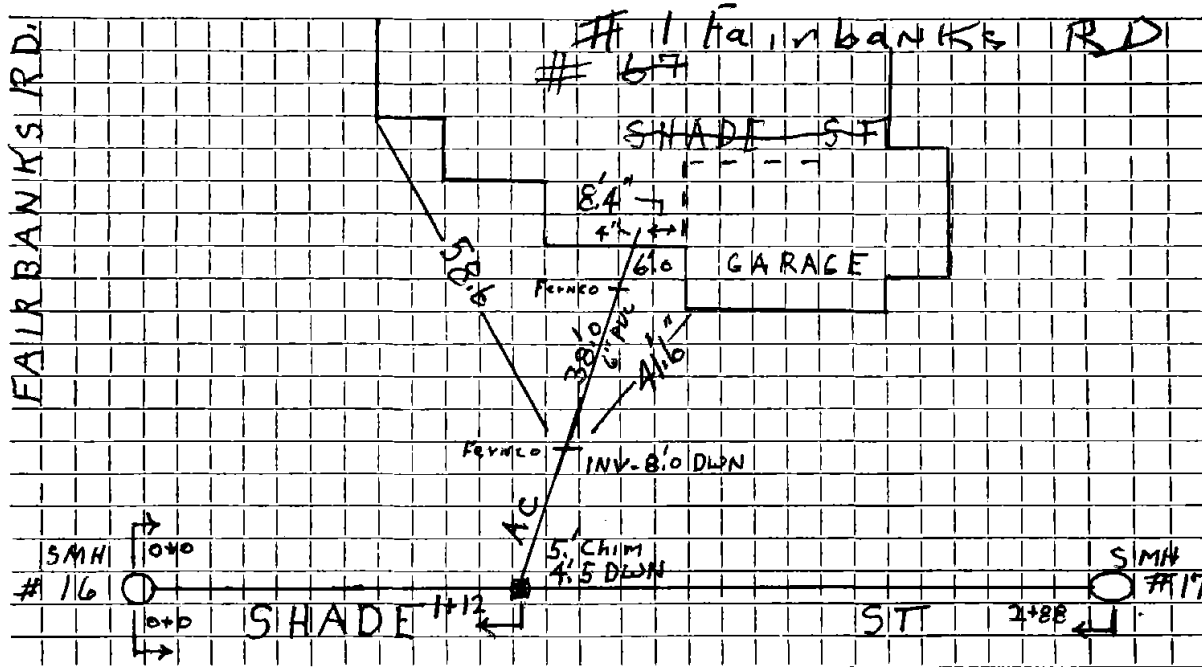

Connection made in \_\_\_\_\_ Street. Work completed 9/28/05 J. McLaughlin

Remarks: Changed To # 1 Fairbanks