

Name Robert A. Nazarian

Service No. 56

Address #11 Fairbanks Rd.

Location

Kind of Pipe

Size

Size of Main

~~Repair—Renewal~~ **New Service** John E. Grant Permit #296

Location AUG 9 1965


Date	Material	Amount	Total	Date	Amount
964	16' 6" Transite pipe @7.00 per ft. installed by contractor		112.00	5-17-65	112.00
-21-65	50' 6" Transite pipe			1964 16' 6" Transite	

B.M.18501

DATE _____

TOWN OF LEXINGTON — BOARD OF PUBLIC WORKS
SEWER DIVISION

Sketch of Service Here **11**

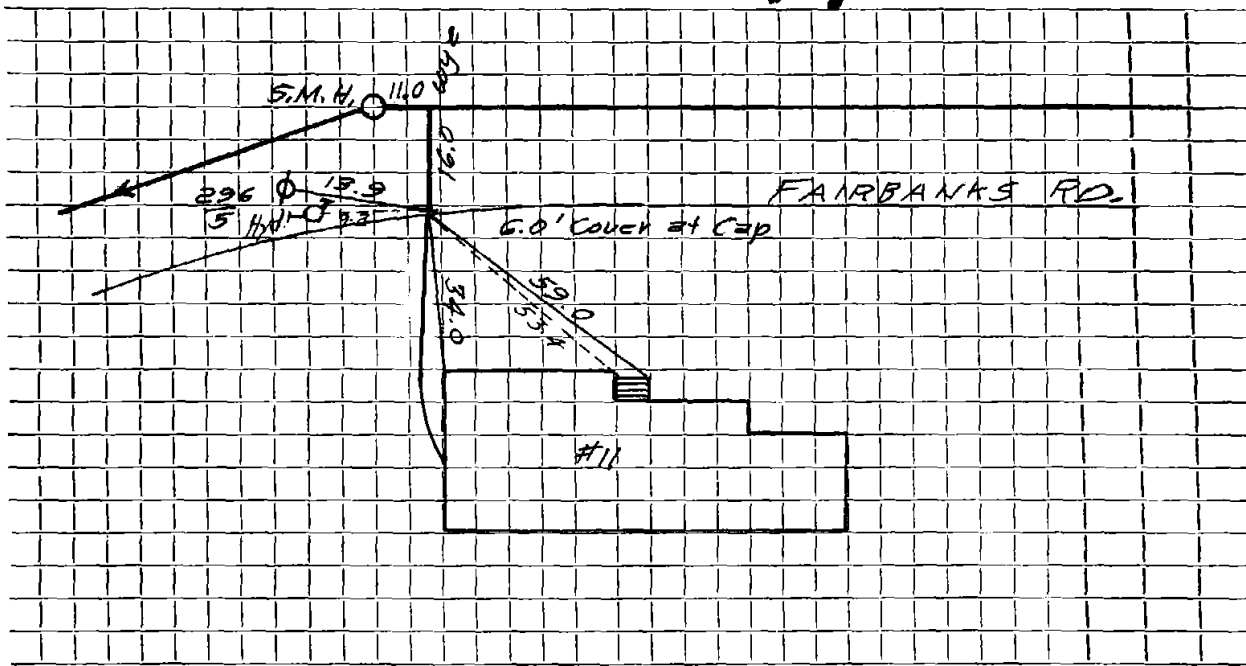

Connection made in Street. Work completed

Remarks:
.....
.....