


DATE _____

TOWN OF LEXINGTON — BOARD OF PUBLIC WORKS
SEWER DIVISION

Sketch of Service Here

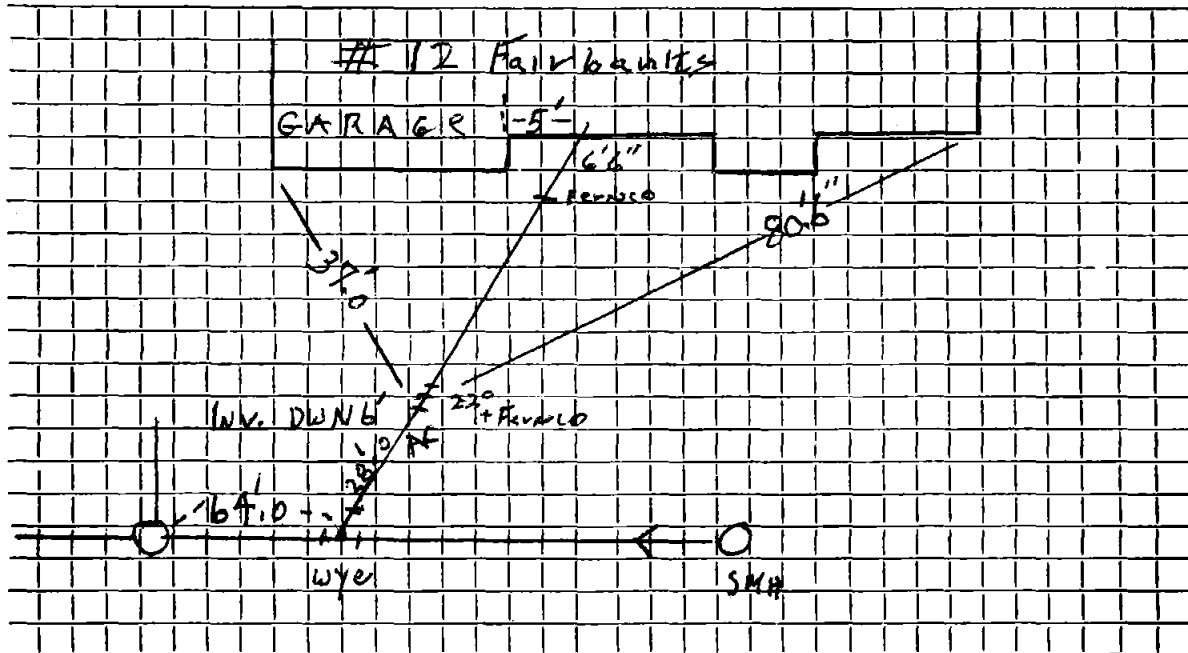

Connection made in _____ Street.

Work completed 12/14/05 J.M. [signature]

Remarks: _____

