
Date: 3/25/24

## TOWN OF LEXINGTON - BOARD OF PUBLIC WORKS SEWER DIVISION

## SKETCH OF SERVICE HERE

## 15 FAIRBANKS RD

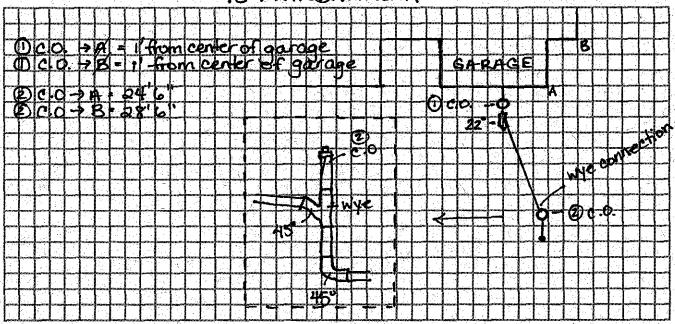

Connection made in:

Street.

Work completed:

Remarks: Installed by RM Rattacorp.

## Sewer Service Record

Name 15 Fa	irbanks Rd		Service No.			
Address						
				Location		
Kind of Pipe SDR 35 PVC			Size 6"	·	Size of Main	8"
Repair Renewal					Location	
Date	Material	Amount	Total	Date		Amount

Date	Material	Amount	Total	Date		Amount
3/25/24	6" SDR 35 PVC					·
	22° bend	1	<del></del>			· ·
	45° bend					
	Wye connection					
	Wye Connection			<u></u>		
<u> </u>	elea 6"cleanout	2	·			·
						,
			,	,		
					·	
		·				<del>                                     </del>
				<u> </u>		