




DATE 10-27-2001

TOWN OF LEXINGTON — BOARD OF PUBLIC WORKS

SEWER DIVISION

Sketch of Service Here

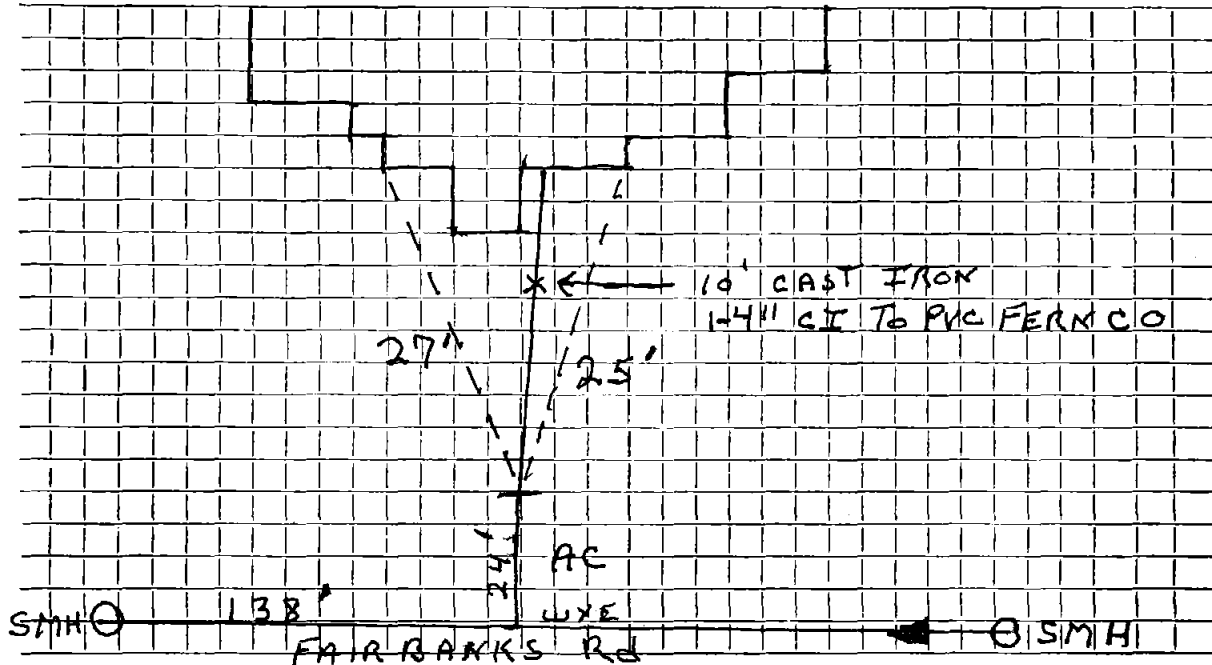

Connection made in FAIRBANKS Rd Street. Work completed 10-27-2001

Remarks: INSTALLED BY J. McLAUGHLIN / CANNIZZO BROS.