

Name Minute Man Masons

Service No. 49

Address # 29 FAIRBANKS RD.

Location LOT # 345 *Area 8-458*

Kind of Pipe

Size

Size of Main

~~REPAIR~~ ~~RENEW~~ — New Service

Location

Date	Material	Amount	Total	Date	Amount	
4-30-58	Labor	43.42		4-8-58	<i>Deposit</i>	100.00
	10% overhead	4.34	47.76			
	54' 6" Transite pipe @.70		37.80			
	1 22½° Bend		6.21			
	2 hrs. Town Shovel @ 6.50		13.00			
	3 hrs. Trucking @.75		2.25			
	1 hr. Rodgers Trailer @ 3.00		3.00			
	1 hr. Trucking @ 3.00		3.00			
			113.02			
	Labor					

TOWN OF LEXINGTON—DEPT. OF PUBLIC WORKS
SEWER DIVISION

DATE

NO.


The undersigned applies for the construction of a particular sewer connecting No.
Street and hereby agrees to comply with the Rules and Regulations governing the construction and use of Particular
Sewers, as now or at any future time established by the Board of Selectmen.

Am't of estimate \$.....

Am't Paid \$.....

..... Owner

Sketch of Service Here

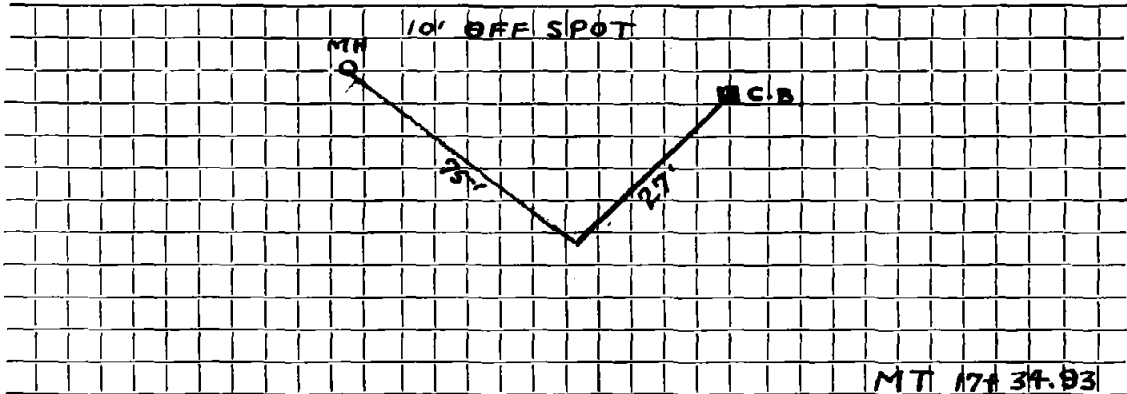

Connection made in Street.

Work completed 19..

Remarks: