

Name Joseph P. Spinelli

Service No. 213

Address # 31 FAIRBANKS RD.

Location LOT # 344

Kind of Pipe

Size

Size of Main

Repair—Renewal—New Service

Location *Comm 12-31-59*

Date	Material	Amount	Total	Date	Amount
10-26-59	Labor	29.65		<i>10-26-59</i>	<i>95.00</i>
	10% O.H.	2.97	32.62	<i>4-23-60</i>	<i>18.93</i>
	50' 6" Transite pipe @.70		35.00		<i>93.93</i>
	1 22 $\frac{1}{2}$ ^o Transite Bend		6.21		
	1 11 $\frac{1}{4}$ ^o Transite Bend		5.10		
	3 hrs. Pippin @.4.50		13.50		
	2 hrs. Trucking @.75		1.50		
			93.93		
	Labor				
				<i>Bill 12-31-59</i>	<i>18.93</i>

TOWN OF LEXINGTON—DEPT. OF PUBLIC WORKS
SEWER DIVISION

DATE

NO.


The undersigned applies for the construction of a particular sewer connecting No.
Street and hereby agrees to comply with the Rules and Regulations governing the construction and use of Particular
Sewers, as now or at any future time established by the Board of Selectmen.

Am't of estimate \$.....

Am't Paid \$.....

..... Owner

Sketch of Service Here

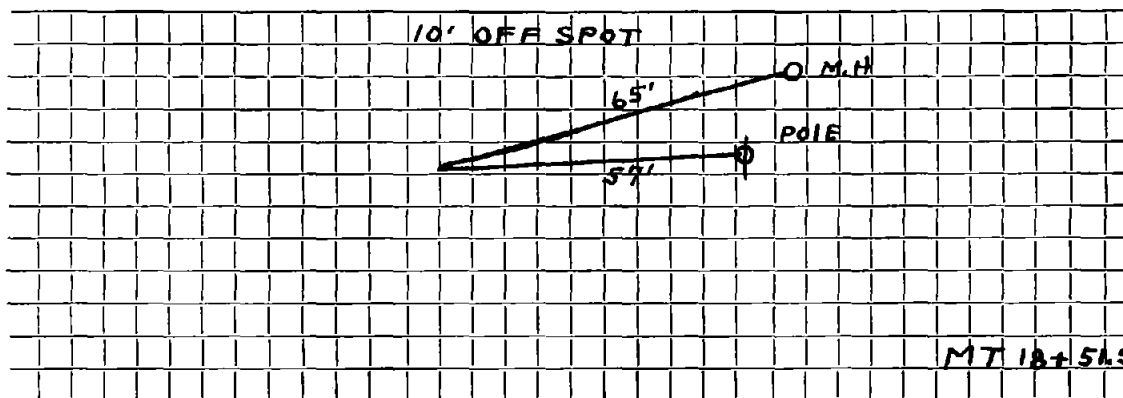

Connection made in Street.

Work completed 19..

Remarks: