

Name **Mario Rossi**

Service No. #134

Address 32 Fairbanks Road

Lot 354

Location

Kind of Pipe

Size

Size of Main

~~REPAIR WORK~~ — New Service

W.O. # ~~7551~~ 7551

Location


Comm 10-29-62

| Date | Material | Amount | Total | Date | | Amount |
|---------|------------------------|--------|--------|----------|-------------|--------|
| 8-23-62 | Labor | 27.93 | | 8-22-62 | Deposit | 109.00 |
| | 10% O.H. | 2.79 | 30.72 | 10-29-62 | Paid by WHP | 14.42 |
| 90' | 6" Transite pipe @.82 | | 73.80 | 11-9-62 | | 21.82 |
| 5 | 3/4 Ton Stone @1.50 | | 8.63 | | | 136.24 |
| 1 | 90° 6" Transite pipe | | 4.09 | | | |
| 2 | Hrs. Town Shovel @6.50 | | 13.00 | | | |
| 2 | Hrs. Trucking @3.00 | | 6.00 | | | |
| | | | 136.24 | | | |

DATE _____

TOWN OF LEXINGTON — BOARD OF PUBLIC WORKS
SEWER DIVISION

Sketch of Service Here **32**

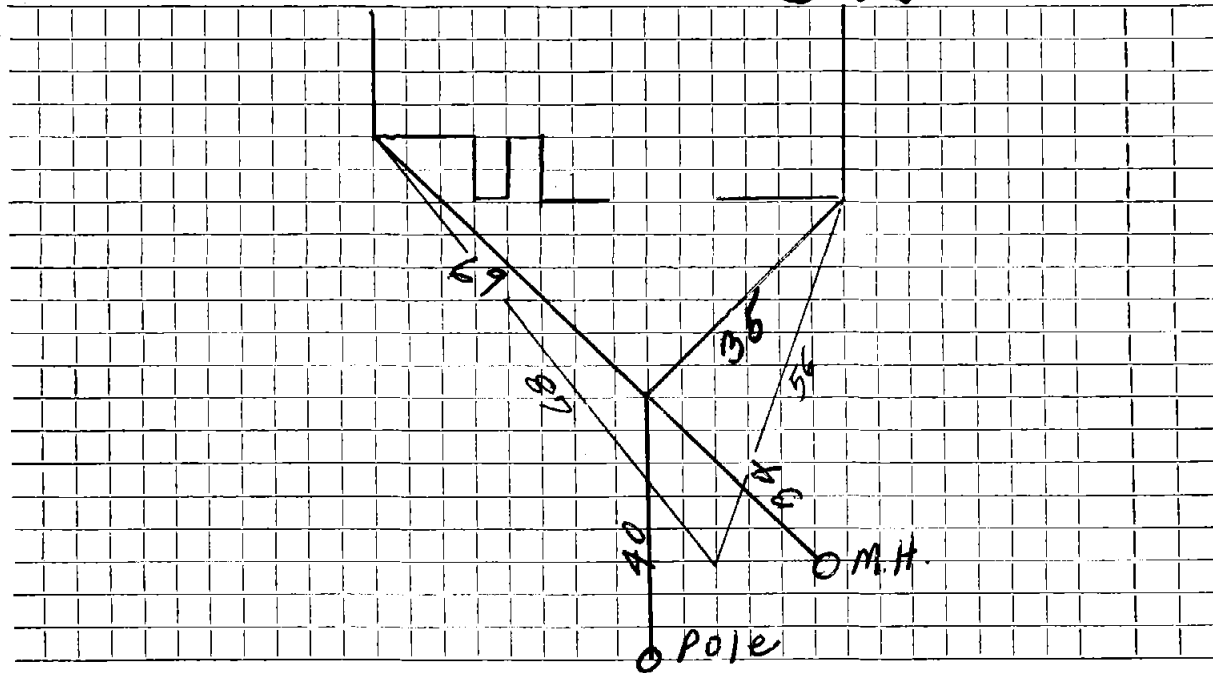

Connection made in Street. Work completed

Remarks:
.....
.....