

Name Harry P. Havelis

Service No. 145 (1956)

Address 33 Fairbanks Road

Location

Comm. 2/25/57

Kind of Pipe

Size

Size of Main

Repair or Renewal — New Service

Location

Date	Material	Amount	Total	Date	Amount
10/20/56	Labor	56 96		10-1-56	Deposit \$ 125 00
	10% overhead	5 70	62 66	2/25/57	Paid by refund
	50' - 6" Sewer pipe @ .435		21 75		on W.H.C. #307 22 42
	Joint compound		3 00		\$ 147 42
	8 2/3 hrs. Littlefield Shovel			7-29-57	Paid
	@ 9.50		82 34		23 83
	2 hrs. trucking @ .75		1 50		# 171 25
			171 25		
	Labor				
				3/24/67	Process
					Bill sent 2/27/57

TOWN OF LEXINGTON—DEPT. OF PUBLIC WORKS
SEWER DIVISION

DATE

NO.


The undersigned applies for the construction of a particular sewer connecting No.
Street and hereby agrees to comply with the Rules and Regulations governing the construction and use of Particular
Sewers, as now or at any future time established by the Board of Selectmen.

Am't of estimate \$.

Am't Paid \$.

..... Owner

Sketch of Service Here

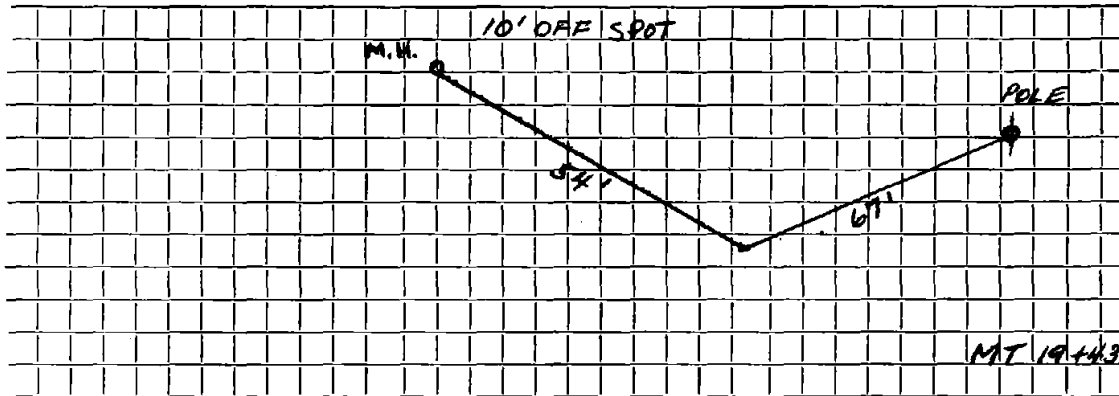

Connection made in Street.

Work completed 19..

Remarks:

