

Name Carey Realty Trust

Service No. 144

Address # 34 FAIRBANKS RD.

Location LOT # 353

Kind of Pipe

Size

Size of Main

~~Repair - Renewal~~ - New Service

Location *Com on 12-31-58*

Date	Material	Amount	Total	Date		Amount
9-9-58	Labor	26.95		<i>8-22-58</i>	<i>Deposit</i>	<i>100.00</i>
	10% O.H.	2.70	29.65	<i>12-31-58</i>	<i>Retained</i>	<i>14.91</i>
48'	6" Transite pipe @.70		33.60			<i>85.09</i>
1	6" 11 $\frac{1}{4}$ " Elbow		2.24			
1	6" 11 $\frac{1}{4}$ " Bend		5.10			
2	hr. Town Shovel @ 6.50		13.00			
2	hr. Trucking @.75		1.50			
			85.09			
	Labor					

TOWN OF LEXINGTON—DEPT. OF PUBLIC WORKS
SEWER DIVISION

DATE

NO.


The undersigned applies for the construction of a particular sewer connecting No.
Street and hereby agrees to comply with the Rules and Regulations governing the construction and use of Particular
Sewers, as now or at any future time established by the Board of Selectmen.

Am't of estimate \$.....

Am't Paid \$.....

..... Owner

Sketch of Service Here

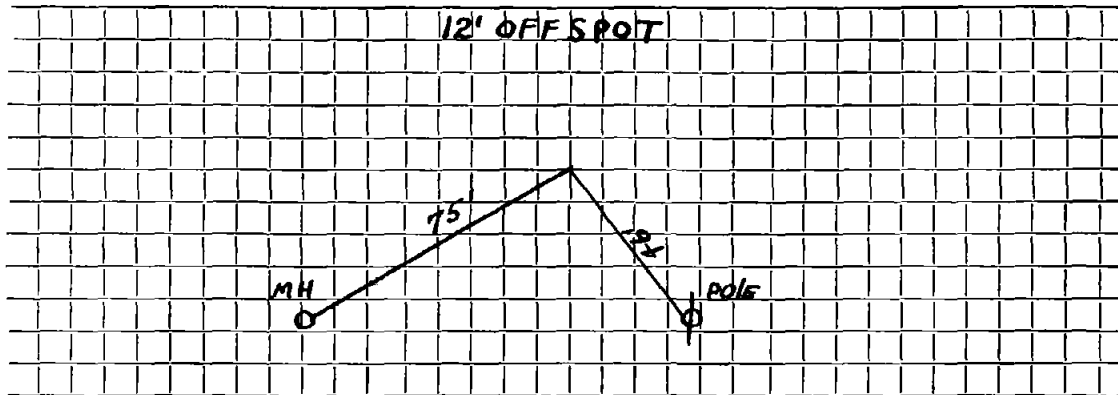

Connection made in Street.

Work completed 19..

Remarks:

