




DATE \_\_\_\_\_

TOWN OF LEXINGTON — BOARD OF PUBLIC WORKS  
SEWER DIVISION

Sketch of Service Here

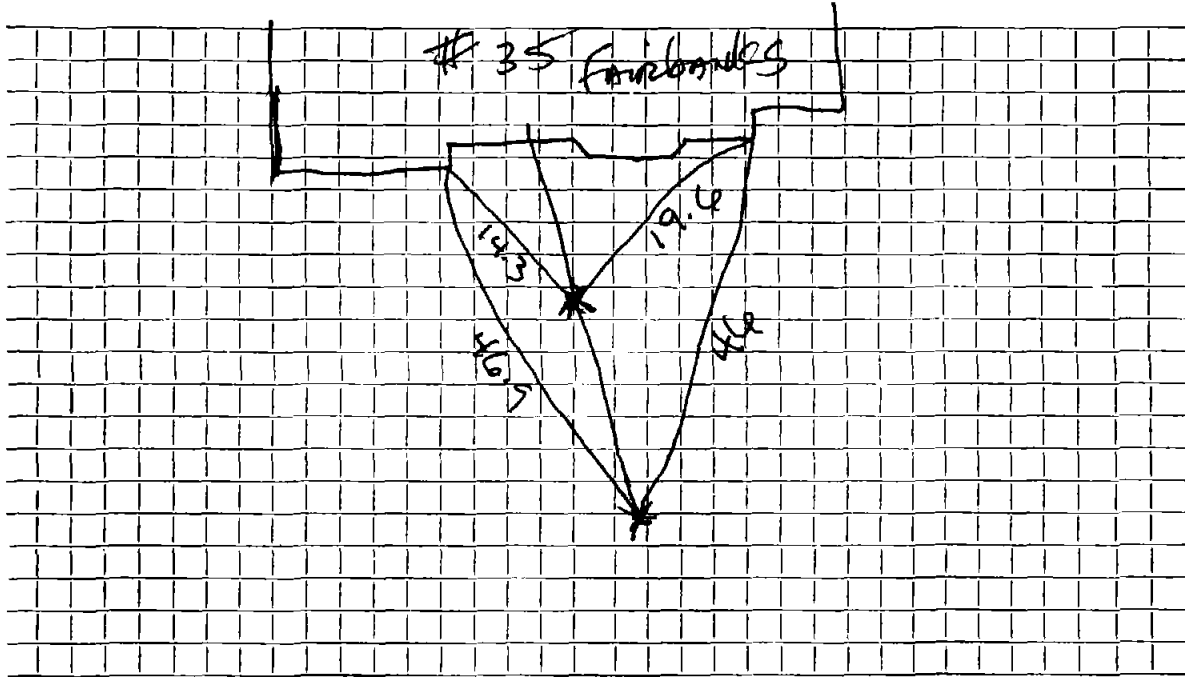

Connection made in ..... Street. Work completed .....

Remarks: ..... FRENCO FOR CONNECTION AT STREET DIRECTLY UNDER  
..... GAS SHUT OFF  
.....