

Name James F. Kelly

Service No. 107

Address # 41 FAIRBANKS RD.

Location LOT # 333

Kind of Pipe

Size

Size of Main

~~Repair/Replacement~~ New Service

Location Comm 11-13-61

Date	Material	Amount	Total	Date	Amount
9-1-61	Labor 11.14			8-17-61	100.00
9-7-61	" 13.14	24.28		11-13-61	19.74
	10% O.H.	2.43	26.71		80.26
	53' 6" Transite pipe @.78		41.34		
	1 22½° Transite Bend		6.21		
	2 hrs. Trucking @3.00		6.00		
			80.26		
	Labor				

# TOWN OF LEXINGTON—DEPT. OF PUBLIC WORKS

## SEWER DIVISION

DATE .....

NO. ....


The undersigned applies for the construction of a particular sewer connecting No. ....  
 Street and hereby agrees to comply with the Rules and Regulations governing the construction and use of Particular  
 Sewers, as now or at any future time established by the Board of Selectmen.

Am't of estimate \$.....

Am't Paid \$.....

..... Owner

**Sketch of Service Here**

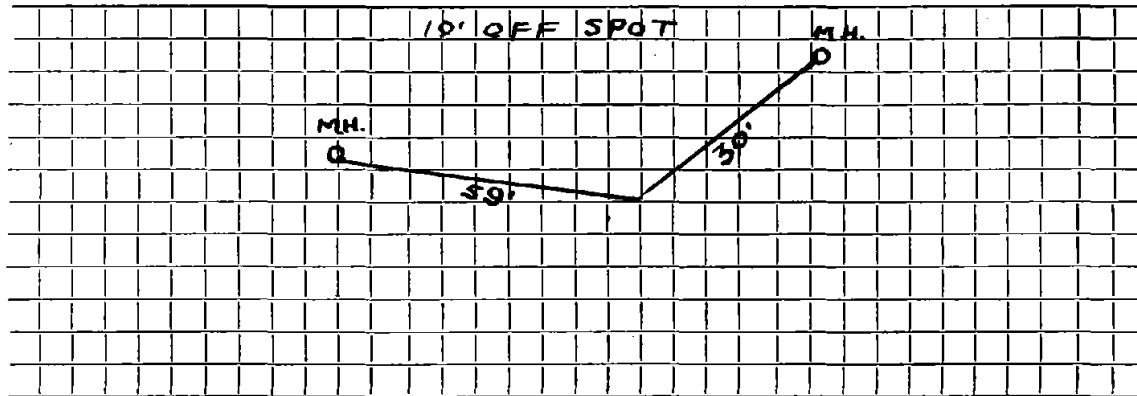

Connection made in ..... Street.

Work completed ..... 19..

Remarks: