




DATE \_\_\_\_\_

TOWN OF LEXINGTON — BOARD OF PUBLIC WORKS

SEWER DIVISION

Sketch of Service Here

7

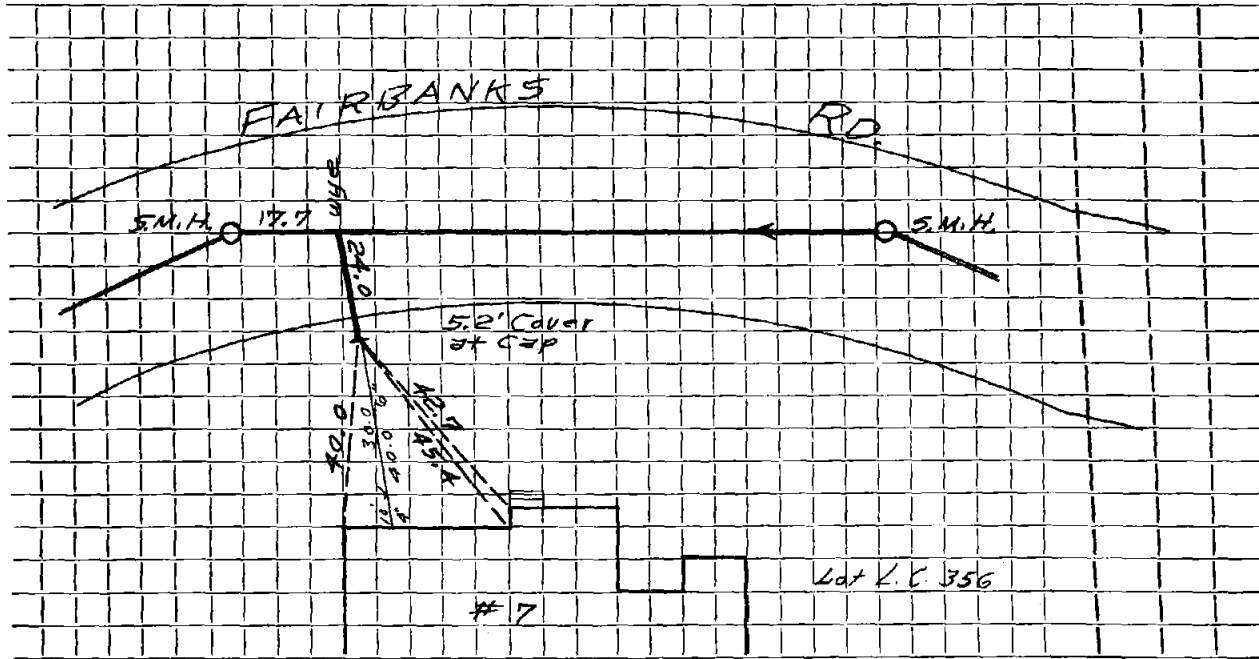

Connection made in ..... Street. Work completed .....

Remarks: .....

.....  
.....




DATE SEPT 8 1997

TOWN OF LEXINGTON — BOARD OF PUBLIC WORKS

SEWER DIVISION

Sketch of Service Here

NO FOUNDATION

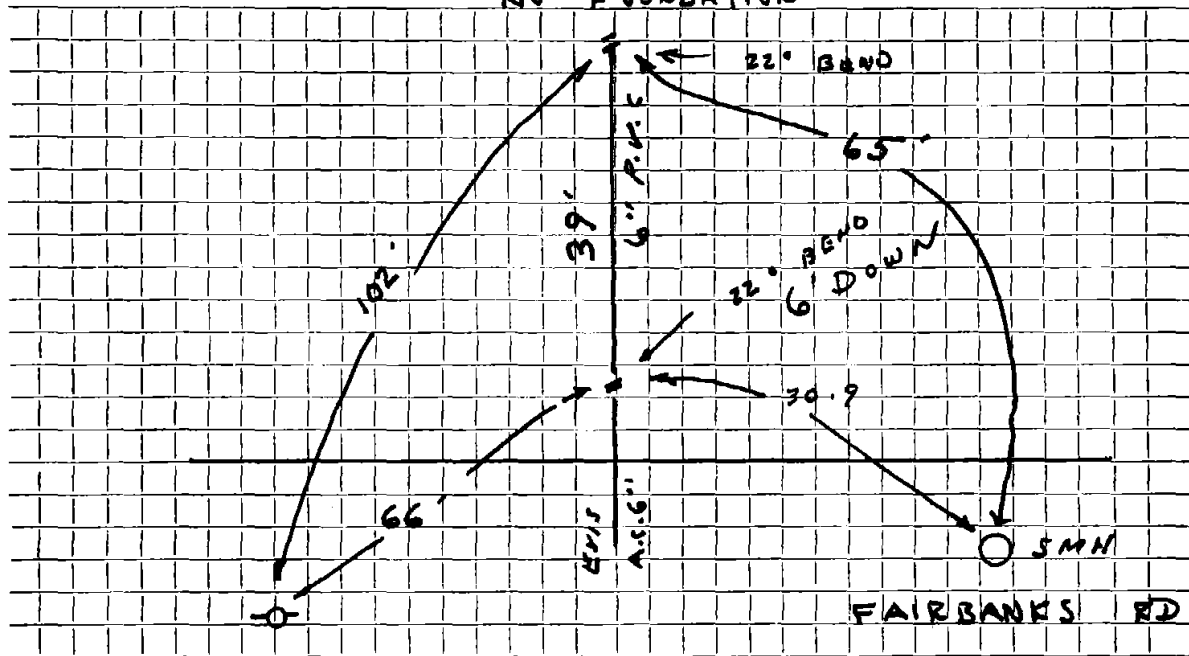

Connection made in FAIRBANKS RD Street.

Work completed FAIRBANKS... JM. M. CLOUGHAN

Remarks: NO FOUNDATION OF TIME OF INSPECTION