


DATE _____

TOWN OF LEXINGTON — BOARD OF PUBLIC WORKS

SEWER DIVISION

Sketch of Service Here

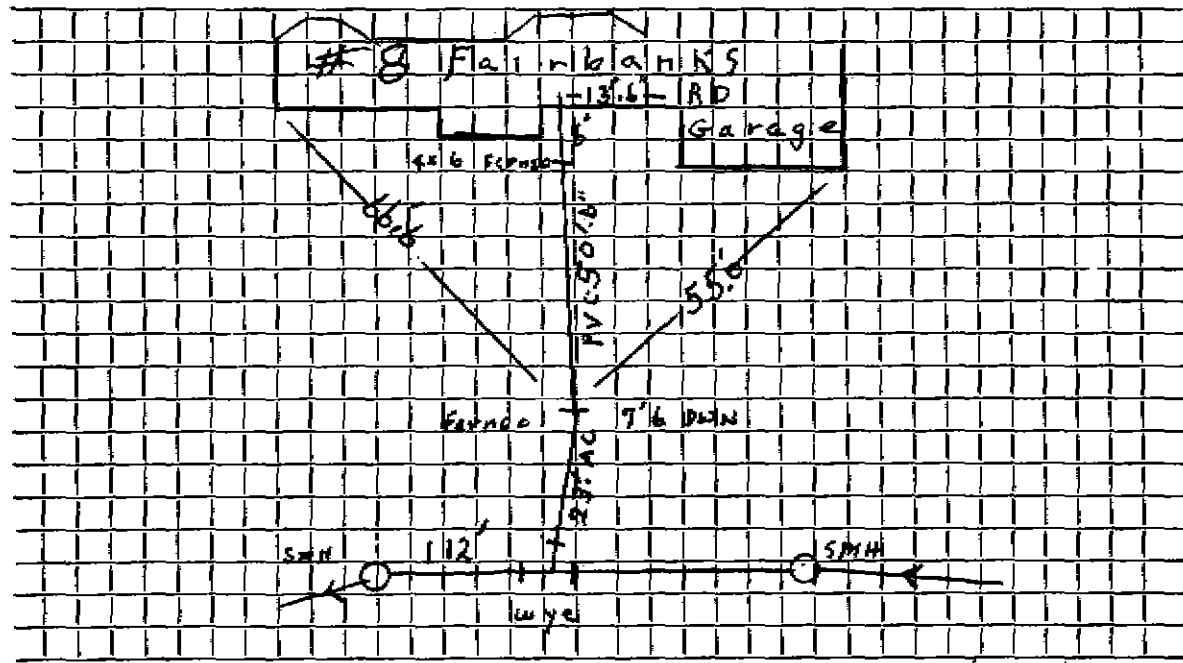

Connection made in Fairbanks RD. Street.

Work completed 5/20/08 J. McLaughlin

Remarks:

.....

.....