

Name Cardinal Associates, Inc.

Service No.

Address 10 Fairfield Drive

Location

Kind of Pipe

Size

Size of Main

Repair—Renewal—New Service

Lucente #2128

Location

Date	Material	Amount	Total	Date	Amount
------	----------	--------	-------	------	--------

8/25/72	33' 6" Transite				
---------	-----------------	--	--	--	--

				5-13-70	
--	--	--	--	---------	--

				35' 6" Transite	
--	--	--	--	-----------------	--


DATE _____

TOWN OF LEXINGTON — BOARD OF PUBLIC WORKS

SEWER DIVISION

Sketch of Service Here

10

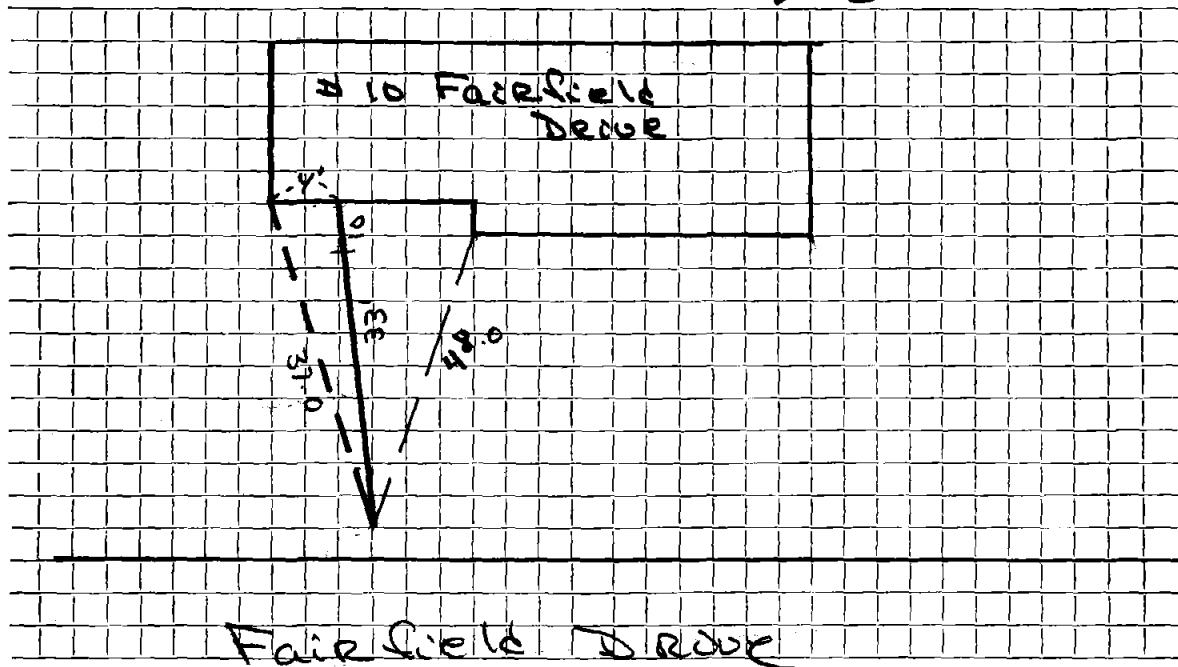

Connection made in Street. Work completed

Remarks:

.....

.....