

Name Oak Park Corp.

Service No.

Address 15 Fairfield Drive

Location

Kind of Pipe

Size

Size of Main

Repair—Renewal—New Service

Lucente #1896
Lucente #1596

Location

Date		Material	Amount	Total	Date		Amount
5-13-70	25'	6" Transite Pipe					
8/25/71	35'	6" Transite pipe					
	10'	4" Cast Iron			5-13-70		
						25' 6" Transite	


HSE #15

DATE _____

TOWN OF LEXINGTON — BOARD OF PUBLIC WORKS
SEWER DIVISION

Sketch of Service Here

15

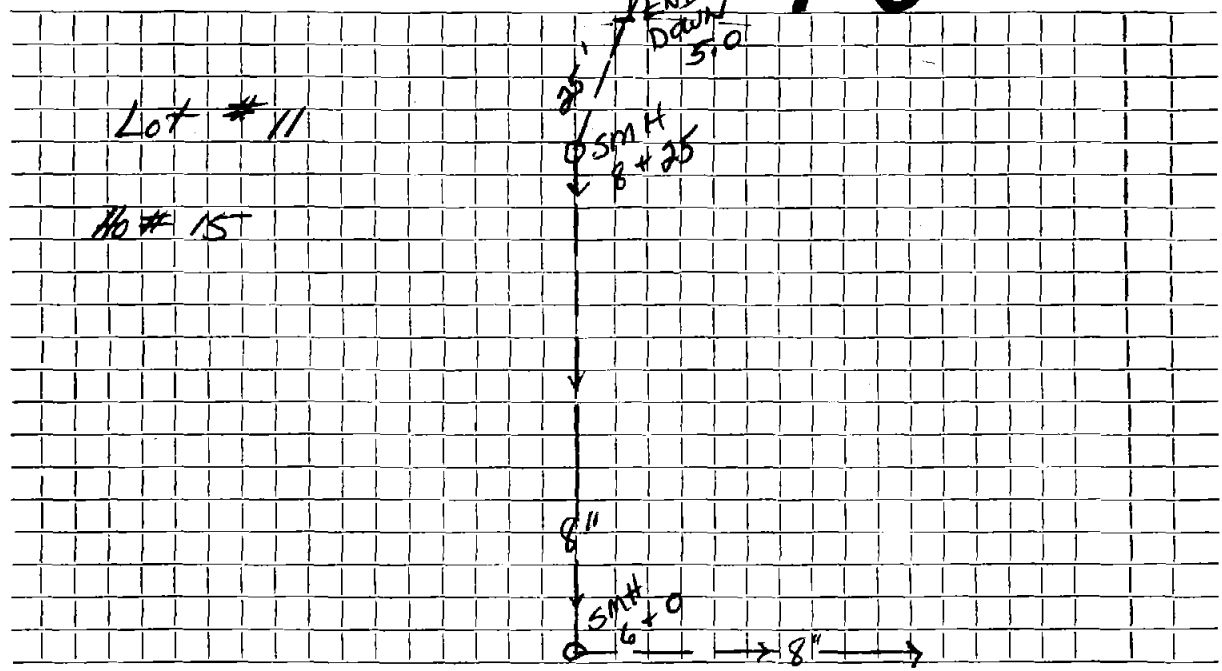

Lot # 11

HSE # 15

SMH
6' + 25"

8"

SMH
6' + 0"

8"

Connection made in Street. Work completed

Remarks:
.....
.....