

Name Oak Park Corp.

Service No.

Address 17 Fairfield Drive

Location

Kind of Pipe

Size

Size of Main

Repair—Renewal—New Service

Lucente #1597

Location


Date	Material	Amount	Total	Date	Amount
5-13-70	55' 6" Transite Pipe				
				5-13-70	
				55' 6" Transite	

DATE _____

TOWN OF LEXINGTON — BOARD OF PUBLIC WORKS

SEWER DIVISION

Sketch of Service Here

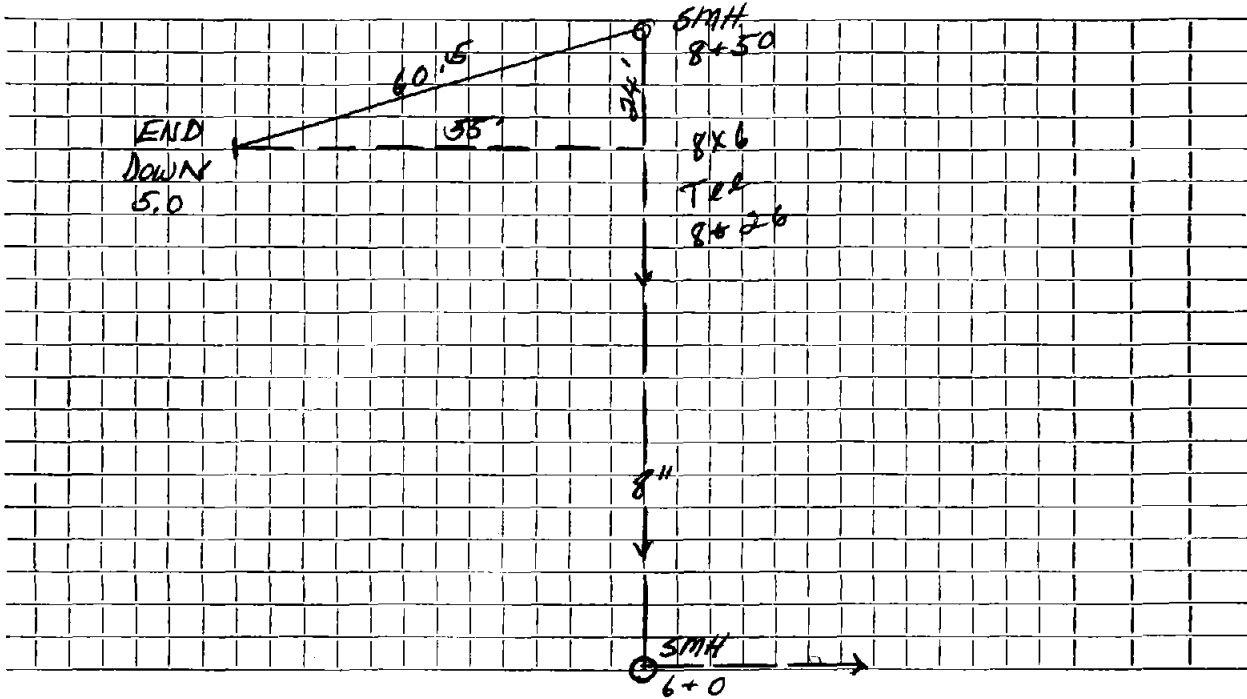

Connection made in Street. Work completed

Remarks:
.....
.....