

Name Cardinal Assoc.

Service No.

Address 2 Fairfield Drive

Location

Kind of Pipe

Size

Size of Main

Repair—Renewal—New Service

Lucente #2228

Location


Date		Material	Amount		Total		Date	Amount	
10/31/73	33'	6" Transite pipe							
	10'	4" Cast Iron pipe							
							5-15-70		
							40' 6" Transite		
							1 8" X 6" Wye		

DATE _____

TOWN OF LEXINGTON — BOARD OF PUBLIC WORKS

SEWER DIVISION

Sketch of Service Here
Lot # 18 **2**

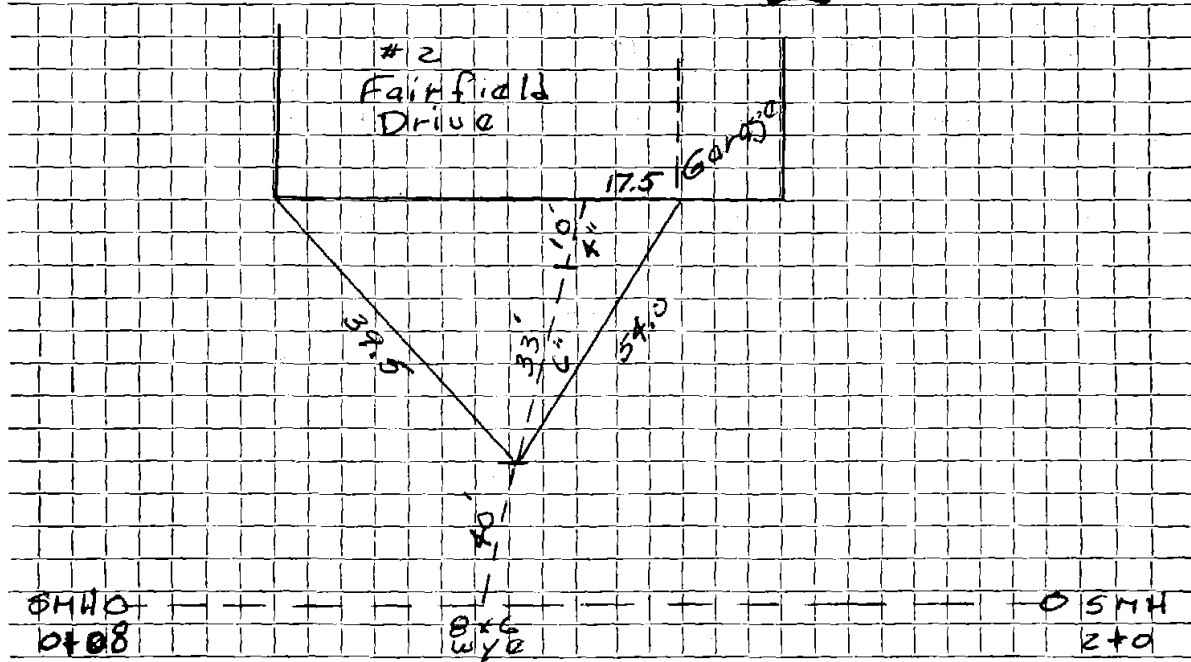

Connection made in Fairfield Drive Street. Work completed

Remarks:

.....

.....