

Name Cardinal Associates

Service No.

Address #4 Fairfield Drive

Location

Kind of Pipe

Size

Size of Main

Repair—Renewal—New Service Lucenta #¹⁵⁸⁸2246


Location

Date	Material	Amount	Total	Date	Amount
5-13-70	30' 6" Transite				
1-24-73	60' 6" ACP 10' 4" C.I.			5-13-70	30' 6" Transite

DATE _____

TOWN OF LEXINGTON — BOARD OF PUBLIC WORKS
SEWER DIVISION

Sketch of Service Here **4**

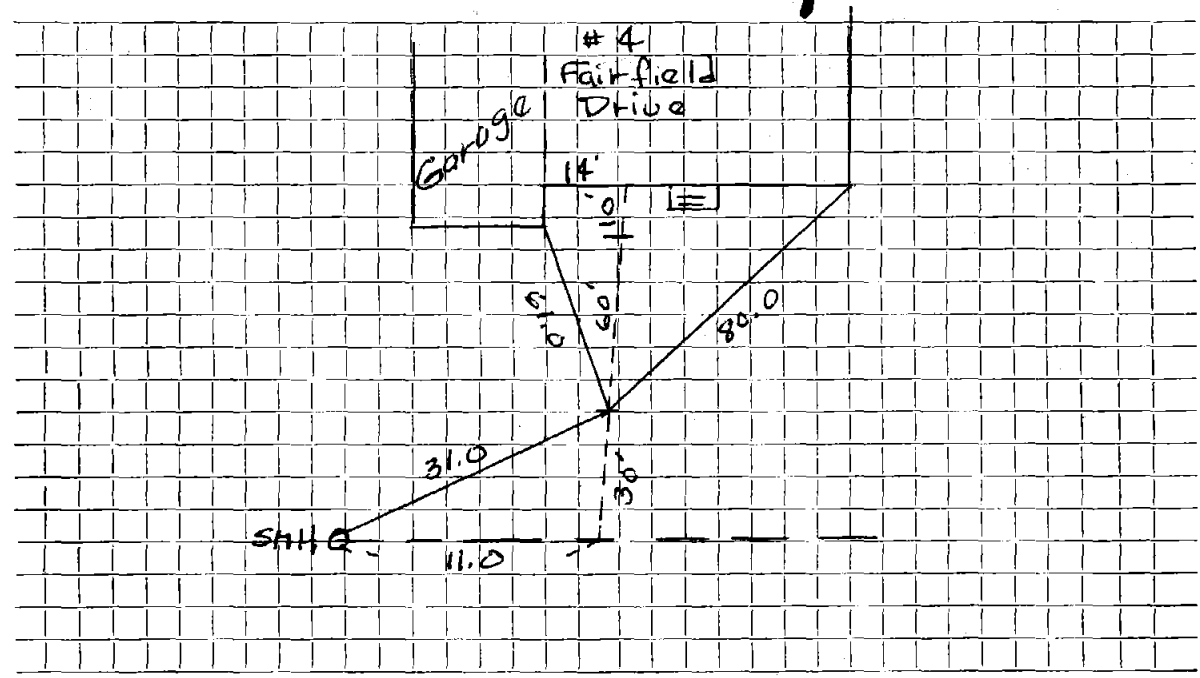

Connection made in Street. Work completed

Remarks:
.....
.....