


DATE _____

TOWN OF LEXINGTON BOARD OF PUBLIC WORKS
SEWER DIVISION

Sketch of Service Here **7**

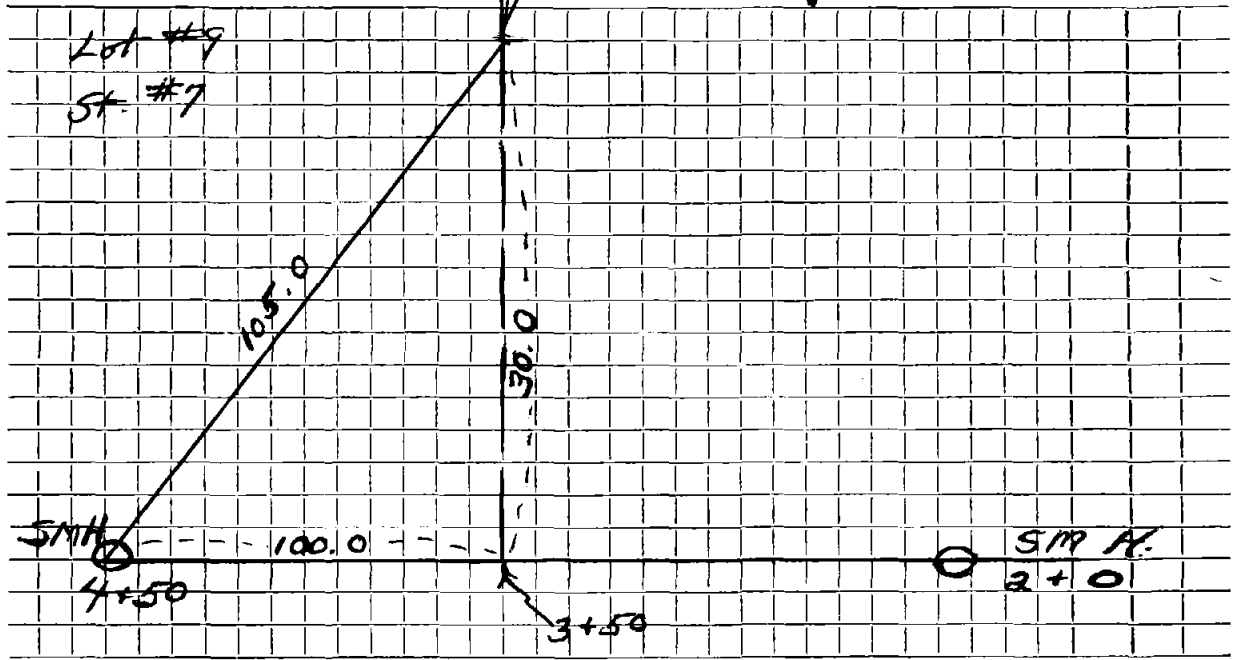

Connection made in Street. Work completed

Remarks:

