

Name Herbert McConchie

Service No. 187 N.D.
(1956)

Address // Fairland Street

Location

Kind of Pipe

Size

Size of Main

~~Repair/Reconnect~~ - New Service

Location

Date	Material	Amount	Total	Date	Amount
10/22/56	Labor	29 60		2/25/57	Paid by refund on S. H. C. #301 ^{1/2} 157 87
10/24/56	"	16 57			
		46 17			
	10% overhead	4 62	50 79		
	50' - 6" Sewer Pipe @ .435		21 75		
	Joint compound		3 00		
	9 1/3 hrs. Littlefield Shovel @ 8.50		79 33		
	4 hrs. Trucking @ .75		<u>3 00</u>		
			157 87		
	Labor				

TOWN OF LEXINGTON—DEPT. OF PUBLIC WORKS

SEWER DIVISION

DATE

NO.


The undersigned applies for the construction of a particular sewer connecting No.
Street and hereby agrees to comply with the Rules and Regulations governing the construction and use of Particular
Sewers, as now or at any future time established by the Board of Selectmen.

Am't of estimate \$.....

Am't Paid \$.....

..... Owner

Sketch of Service Here

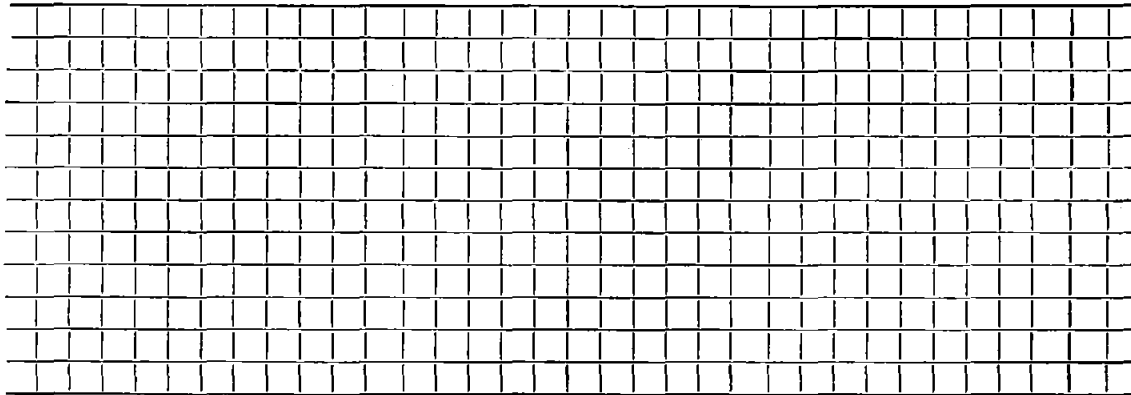

Connection made in Street.

Work completed 19..

Remarks: