

Name

Service No. 1799

Address 21 Fairland ST

Location

Kind of Pipe PVC

Size 6"

Size of Main

Repair—Renewal—New Service

T. D. J. McLaughlin

Location


Date	Material	Amount	Total	Date	Amount
6/22/05	6' 4" Sch 40 PVC				
	14 1/2' 6" PVC				
	1 6" Clean out				
	EXIST 120 ST.				
	Clay Pipe				
1 N. ST.	10' of Clay Replaced w/ 6" PVC				

DATE _____

TOWN OF LEXINGTON — BOARD OF PUBLIC WORKS

SEWER DIVISION

Sketch of Service Here

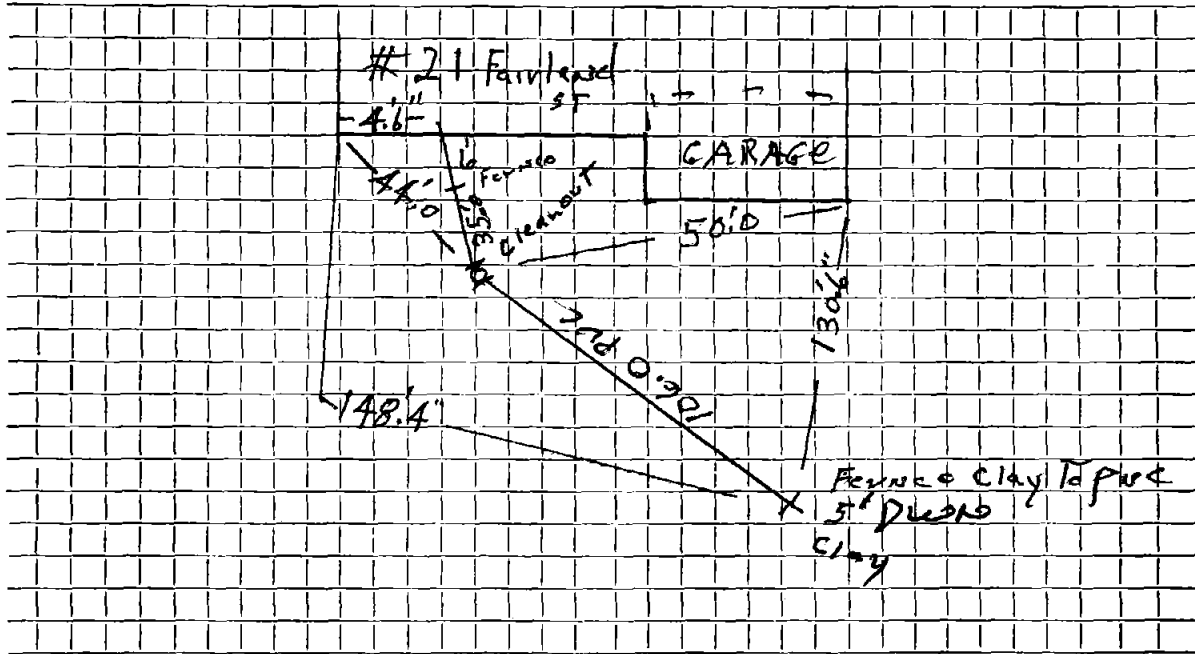

Connection made in Fairland ST Street. Work completed 6/22/05 J. McLaughlin

Remarks: 10' of PVC IN Fairland ST. (Roots in Clay Pipe)
Replaced