

Name Herbert McConchie

Service No. 7

Address 6 Fairland Street

Location Comm. 4/29/57

Kind of Pipe

Size

Size of Main

~~Repair~~ ~~Renewal~~ New Service

Location

Date	Material	Amount	Total	Date	Amount
2/26/57	Labor	61 00		2-20-57	Deposit #150 00
2/27/57	"	18 53		4-29-57	Paid by Ref. av 4 63
		79 53			W.H.C. #1 #154 63
	10% overhead	7 95	87 48	6-5-57	Paid 17 60
	73' - 6" Transite pipe @ .7020		51 25		#172 23
	2 hrs. Compressor @ 3.00		6 00		
	4 hrs. Town Shovel @ 6.50		26 00		
	2 hrs. trucking @ .75		1 50		
			172 23		
	Labor				
					Bill sent 5/2/57

TOWN OF LEXINGTON—DEPT. OF PUBLIC WORKS

**SEWER DIVISION**

DATE .....

NO. ....


The undersigned applies for the construction of a particular sewer connecting No. ....  
Street and hereby agrees to comply with the Rules and Regulations governing the construction and use of Particular  
Sewers, as now or at any future time established by the Board of Selectmen.

Am't of estimate \$. ....

Am't Paid \$. ....

..... Owner

**Sketch of Service Here**

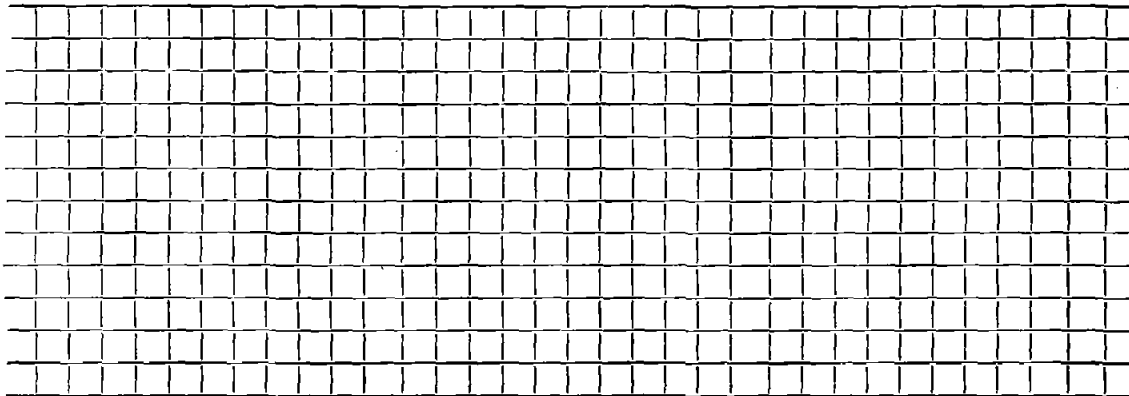

Connection made in ..... Street.

Work completed ..... 19..

Remarks: