

Name Herbert McConchie

Service No. 91

Address 4 Fairland Street

Location

Comm. 10-8-56

Kind of Pipe

Size

Size of Main

~~Repair~~ ~~Renewal~~ — New Service

Location

Date	Material	Amount	Total	Date	Amount
7/26/56	Labor	17 00		7-13-56	Deposit P 150 00
7/27/56	"	31 50		10-5-56	Paid by refund
	10% Overhead	4 85	53 35		on W.K.C. #211
	60' 6" Sewer Pipe @ .455		27 30		# 151 29
	1 6" Elbow		1 88		
	Joint Compound		3 60	3-31-06	Clean Out Pot
	7 2/3 hrs. Littlefield @ 8.50		65 16		In By John's
			151 29		Sewer.
					JMsr
	Labor				

TOWN OF LEXINGTON—DEPT. OF PUBLIC WORKS
SEWER DIVISION

DATE.....

NO.


The undersigned applies for the construction of a particular sewer connecting No.....
Street and hereby agrees to comply with the Rules and Regulations governing the construction and use of Particular
Sewers, as now or at any future time established by the Board of Selectmen.

Am't of estimate \$.....

Am't Paid \$.....

..... Owner

Sketch of Service Here

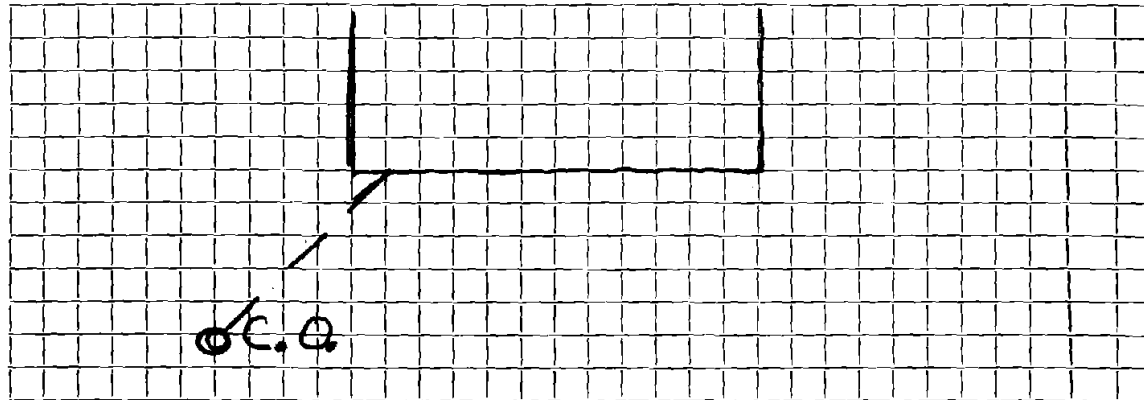

Connection made in..... Street.

Work completed.....19..

Remarks:

