

Name

Service No.

Address 30 FAIRLAWN

McEVOT

Location

Kind of Pipe

Size

Size of Main

~~Repair~~ ~~Renewal~~ New Service


Location

Date	Material	Amount	Total	Date	Amount
3/2018	6" SDR				
	6" CLEAN OUT				
	· 6" PVC CAP				
	· 6" SDR RISER				
	· 6" WYE				
	45° PVC BEND	(2)			
	6" x 6" FURNO				

DATE 3/2018

TOWN OF LEXINGTON — BOARD OF PUBLIC WORKS
SEWER DIVISION

Sketch of Service Here

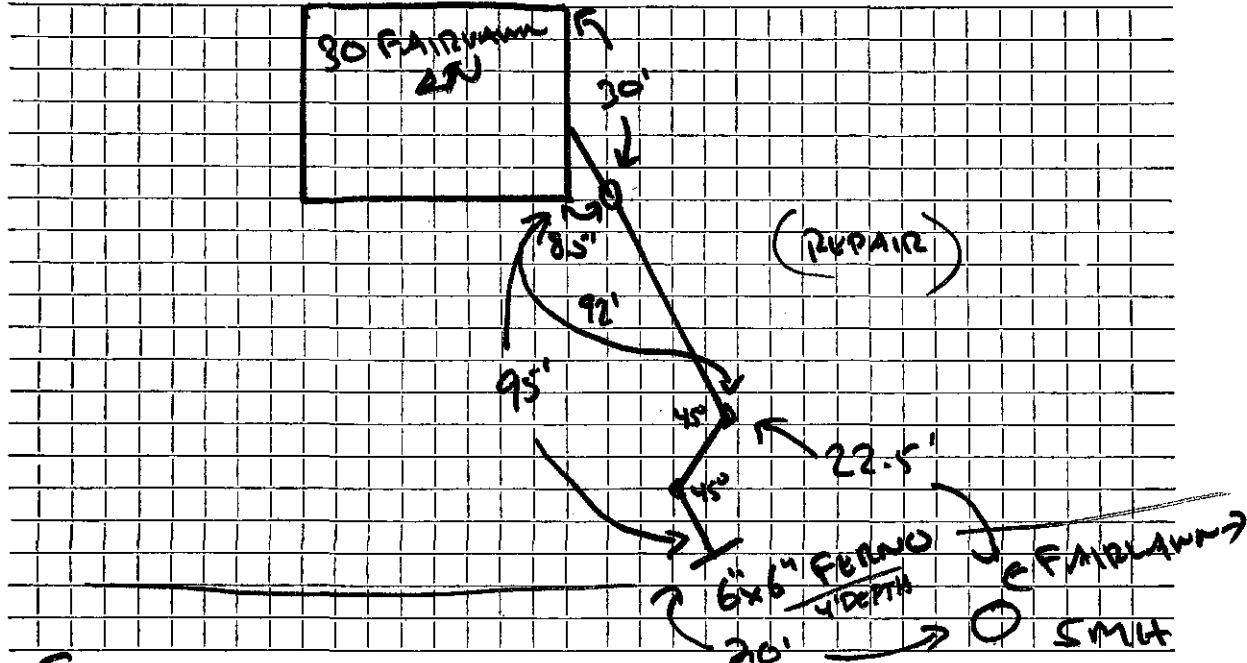

Connection made in FAIRLAWN Street. Work completed MCIVER BROS.

Remarks:

.....

.....