


DATE 06/14/23

TOWN OF LEXINGTON — BOARD OF PUBLIC WORKS
SEWER DIVISION

Sketch of Service Here
10 Fairlawn Ln.

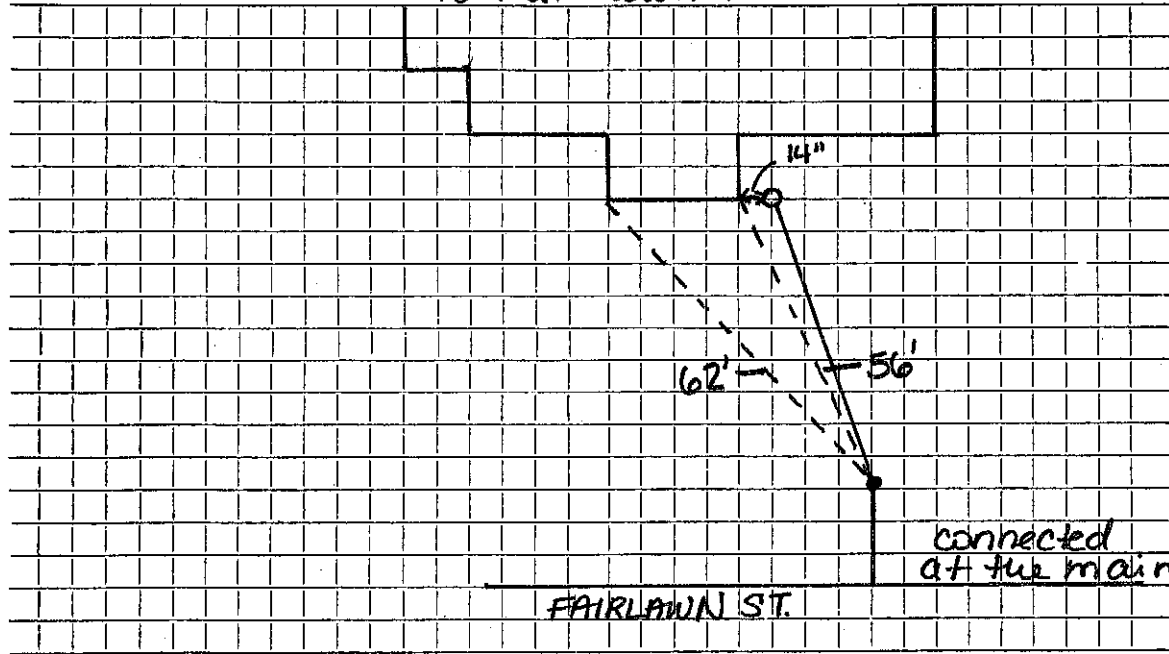

Connection made in Street. Work completed

Remarks: Installed by McLaughlin Inc.