

Name DeVries Const. Co., Inc.

Service No. _____

Address 16 Fair lawn Lane

Location _____

Kind of Pipe _____

Size _____

Size of Main _____

Repair—Renewal—New Service _____

Installed by developer

Location _____

| Date | Material | Amount | Total | Date | | Amount |
|---------|--------------|--------|-------|---------|-------------------------------|--------|
| 3/10/55 | | | | | | |
| | | | | | <i>Repair #4979 - Trebino</i> | |
| | | | | 7/16/87 | 165' 6" PVC | |
| | | | | | 6' 4" PVC | |
| | | | | | 3 22° Bends | |
| | | | | | 3 6 x 6 x 4 Wye Cleanouts | |
| | | | | | 1 6 x 4 Fernco | |
| | | | | | 1 6 x 6 x 6 Wye | |
| | Labor | | | | | |

TOWN OF LEXINGTON—DEPT. OF PUBLIC WORKS

SEWER DIVISION

DATE.....

NO.


The undersigned applies for the construction of a particular sewer connecting No.....
 Street and hereby agrees to comply with the Rules and Regulations governing the construction and use of Particular
 Sewers, as now or at any future time established by the Board of Selectmen.

Am't of estimate \$.....

Am't Paid \$.....

..... Owner

Sketch of Service Here

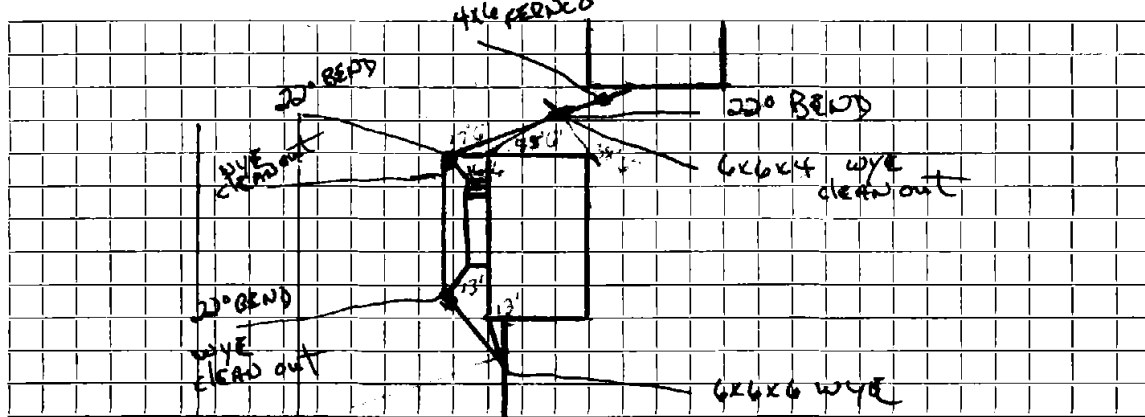

Connection made in Street.

Remarks:

DRIVE WAY
for post

Work completed..... 19..