

Name

Contractor: TBR Excavating

Service No.

Address

17 Fairlawn Ln

Location

Kind of Pipe

SDR 35 PVC

Size

6"

Size of Main

Repair

~~Renewal~~

New Service

Location

Date

Material

Amount

Total

Date

Amount

11/13/20

Cut in tee  
w/ 45° bend

6" SDR35 PVC


4" cleanout 7' deep

6" SDR35 PVC

DATE 11/13/20

TOWN OF LEXINGTON — BOARD OF PUBLIC WORKS

SEWER DIVISION

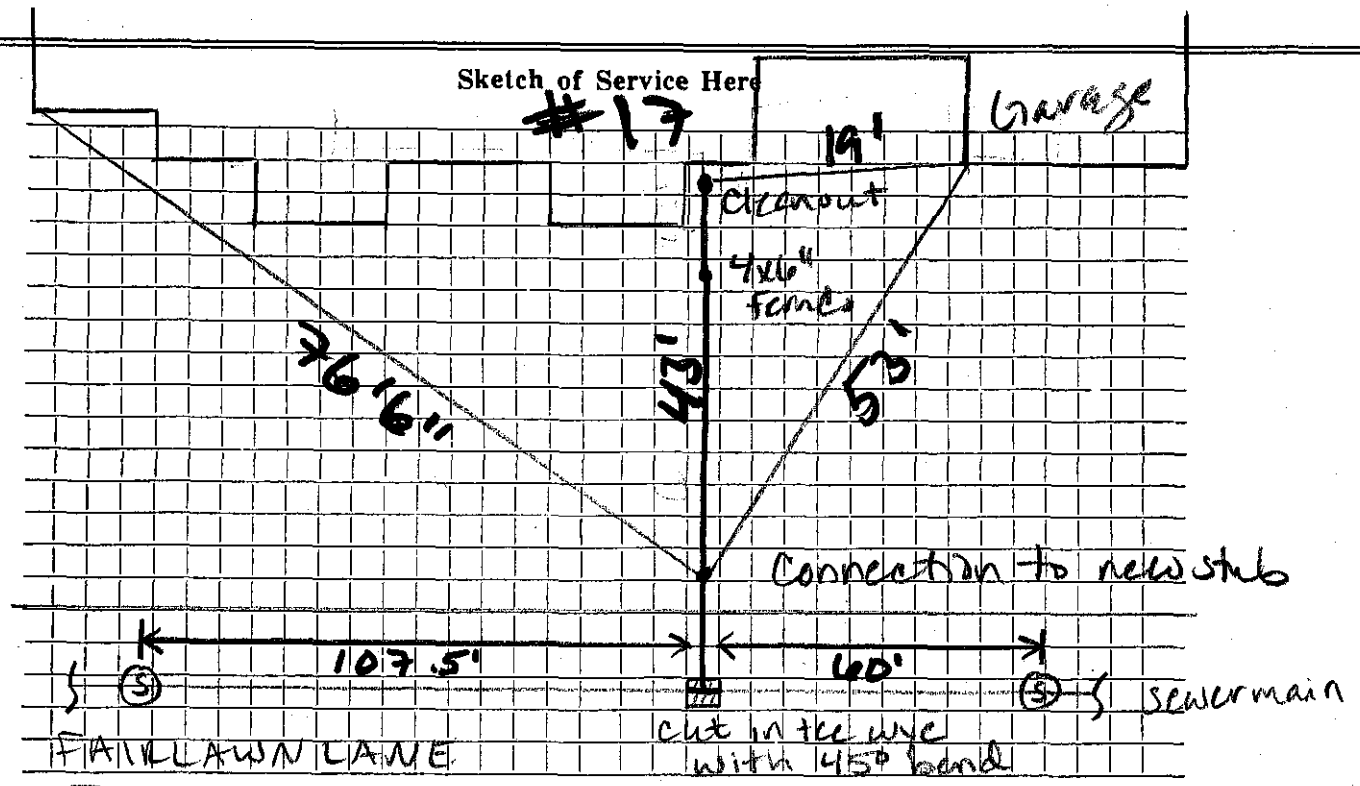

Connection made in ... Fairlawn Lane Street Work completed .....

Remarks: Connection to main done on 11/13/20  
Connection to new stub done on 12/2020