

Name DeVries Construction Company, Incorporated

Service No.

Address 24 Fairlawn Lane

Location

Kind of Pipe

Size

Size of Main

Repair—Renewal—New Service

Installed by developer

Location

Date

Material

Amount

Total

Date

Amount

11/15/55


Labor

DATE _____

TOWN OF LEXINGTON — BOARD OF PUBLIC WORKS

SEWER DIVISION

Sketch of Service Here

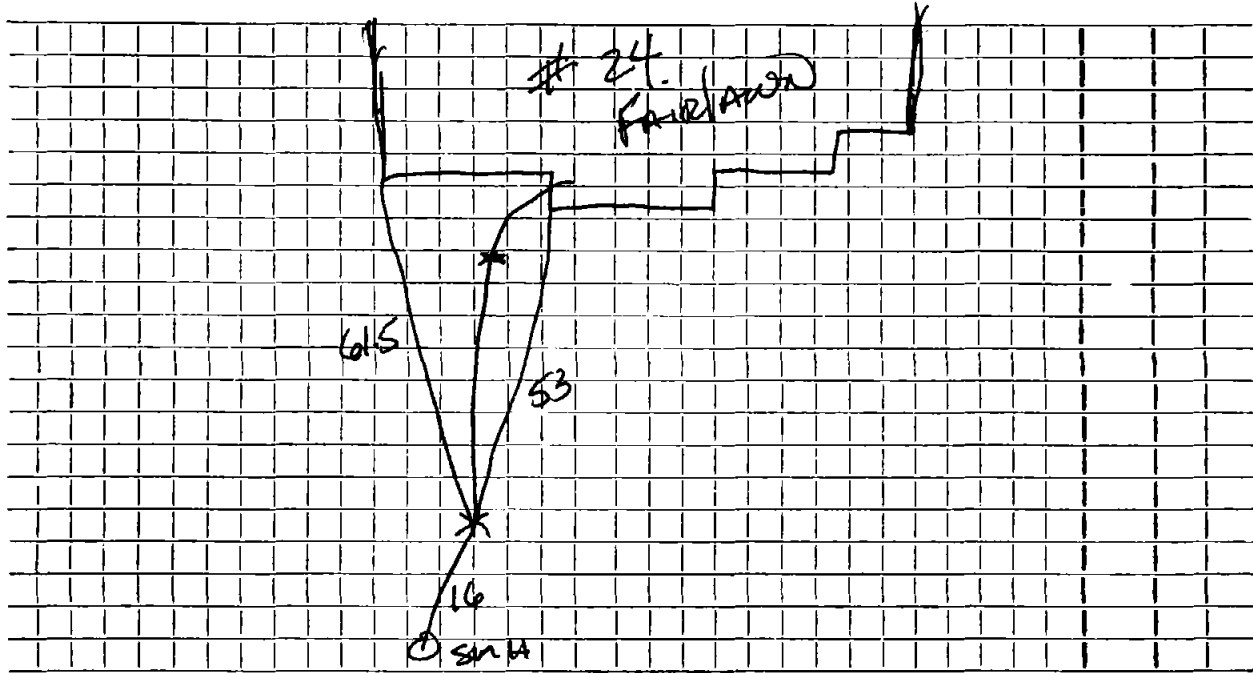

Connection made in Street. Work completed

Remarks: SERVICE GOES INTO M.H.