

TOWN OF LEXINGTON—DEPT. OF PUBLIC WORKS
SEWER DIVISION

DATE.....

NO.


The undersigned applies for the construction of a particular sewer connecting No.....
 Street and hereby agrees to comply with the Rules and Regulations governing the construction **and** use of Particular
 Sewers, as now or at any future time established by the Board of Selectmen.

Am't of estimate \$.

Am't Paid \$.

..... Owner

Sketch of Service Here

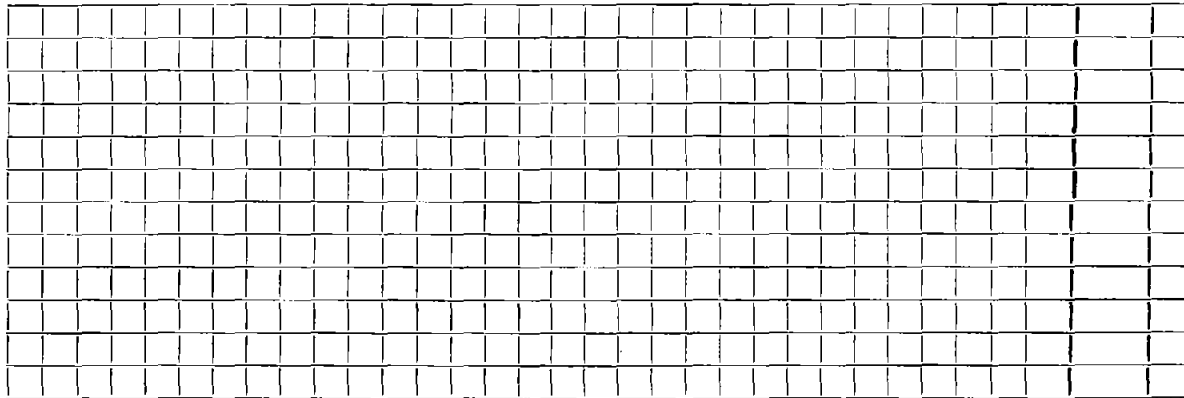

Connection made in..... Street.

Work completed..... 19..

Remarks:

