


DATE 10/20/21

TOWN OF LEXINGTON — BOARD OF PUBLIC WORKS
SEWER DIVISION

Sketch of Service Here

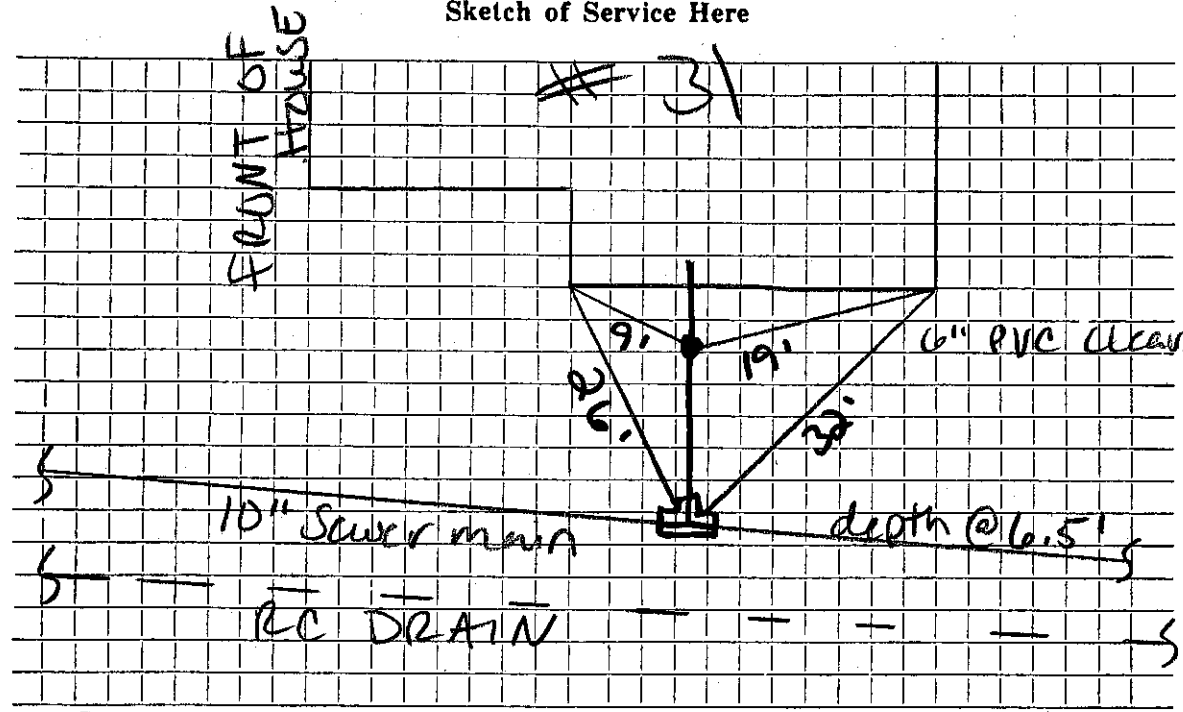

2-Furncos & tee wye 10"x6"

Connection made in Fairlawn Ln ~~Street~~

Work completed [old service was illegally connected to drain main. Chopped old sewer 1' out from drain]

Remarks: easement
depth drainage main in easement = 4.5'
depth sewer main in easement = 6.5'