

Name DeVries Co.

Service No.

Address 11 Fairlawn Lane

Location

Kind of Pipe

Size

Size of Main

~~Repair Renewal~~ — New Service

Location

Date	Material	Amount	Total	Date		Amount
------	----------	--------	-------	------	--	--------

1954

INSTALLED BY DEVELOPER

81'

Labor

TOWN OF LEXINGTON—DEPT. OF PUBLIC WORKS
SEWER DIVISION

DATE.....

NO.


The undersigned applies for the construction of a particular sewer connecting No.....
Street and hereby agrees to comply with the Rules and Regulations governing the construction and use of Particular
Sewers, as now or at any future time established by the Board of Selectmen.

Am't of estimate \$.....

Am't Paid \$.....

..... Owner

Sketch of Service Here

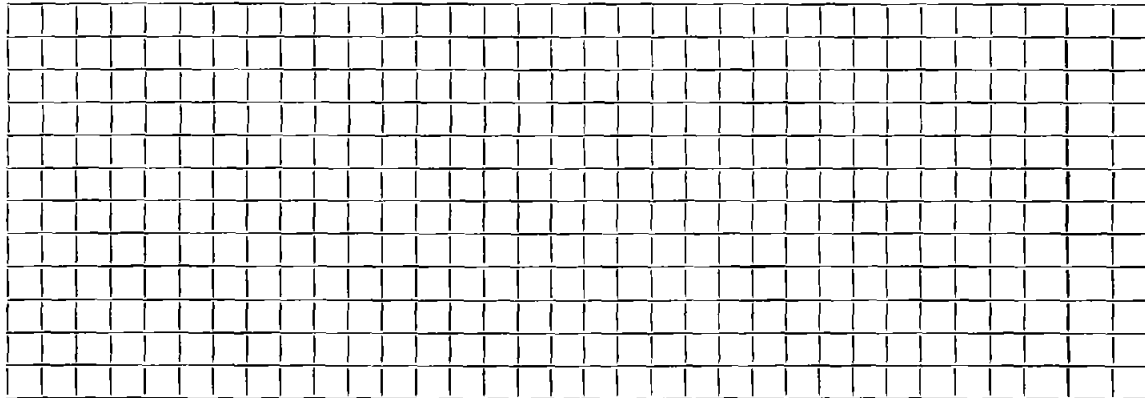

Connection made in..... Street.

Work completed..... 19..

Remarks:

Name DeVries Const. Co., Inc.

Service No. _____

Address 4 Fairlawn Lane

Location _____

Kind of Pipe _____

Size _____

Size of Main _____

Repair—Renewal—New Service _____

Installed by developer _____

Location _____

Date

Material

Amount

Total

Date

Amount

9/30/54

Labor

TOWN OF LEXINGTON—DEPT. OF PUBLIC WORKS
SEWER DIVISION

DATE.....

NO.

The undersigned applies for the construction of a particular sewer connecting No.....
Street and hereby agrees to comply with the Rules and Regulations governing the construction and use of Particular
Sewers, as now or at any future time established by the Board of Selectmen.

Am't of estimate \$.

Am't Paid \$.

..... Owner

Sketch of Service Here

Connection made in..... Street. Work completed.....19..

Remarks: