


DATE MAY 8 1998

TOWN OF LEXINGTON — BOARD OF PUBLIC WORKS
SEWER DIVISION

Sketch of Service Here

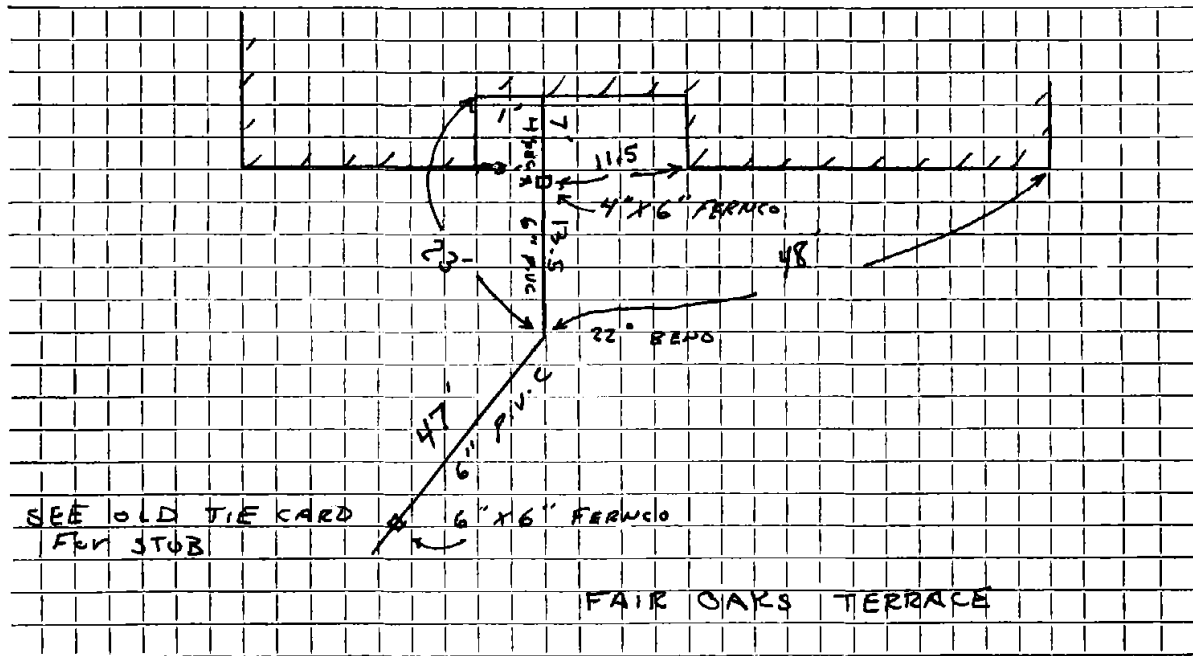

Connection made in FAIR OAKS TERRACE Street.

Work completed J.M. MCLAUGHLIN

Remarks:

FIELD BOOK 98-1

TJM