


DATE Nov. 19, 1980

TOWN OF LEXINGTON — BOARD OF PUBLIC WORKS
SEWER DIVISION

Sketch of Service Here

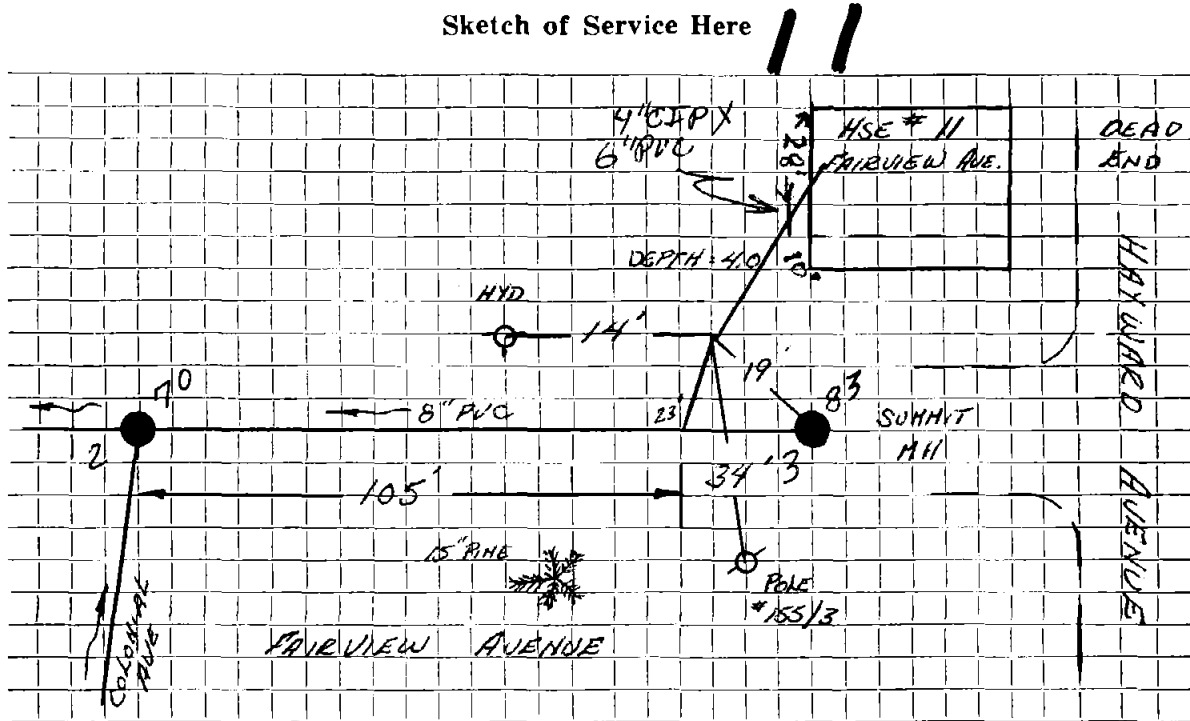

Connection made in ... FAIRVIEW Street. Work completed ... Nov. 19, 1980

Remarks:

.....

.....