

Name

Service No.

Address

FAIRVIEW AVENUE (VACANT LOT)

Location

Kind of Pipe

PVC

Size

6"

Size of Main

8"

Repair—Renewal—New Service

NEW SERVICE

Location

Date

Material

Amount

Total

Date

Amount

Nov. 21, 1980

21' of 6" PVC


14 00

294 00

DATE Nov. 21, 1980

TOWN OF LEXINGTON — BOARD OF PUBLIC WORKS
SEWER DIVISION

Sketch of Service Here

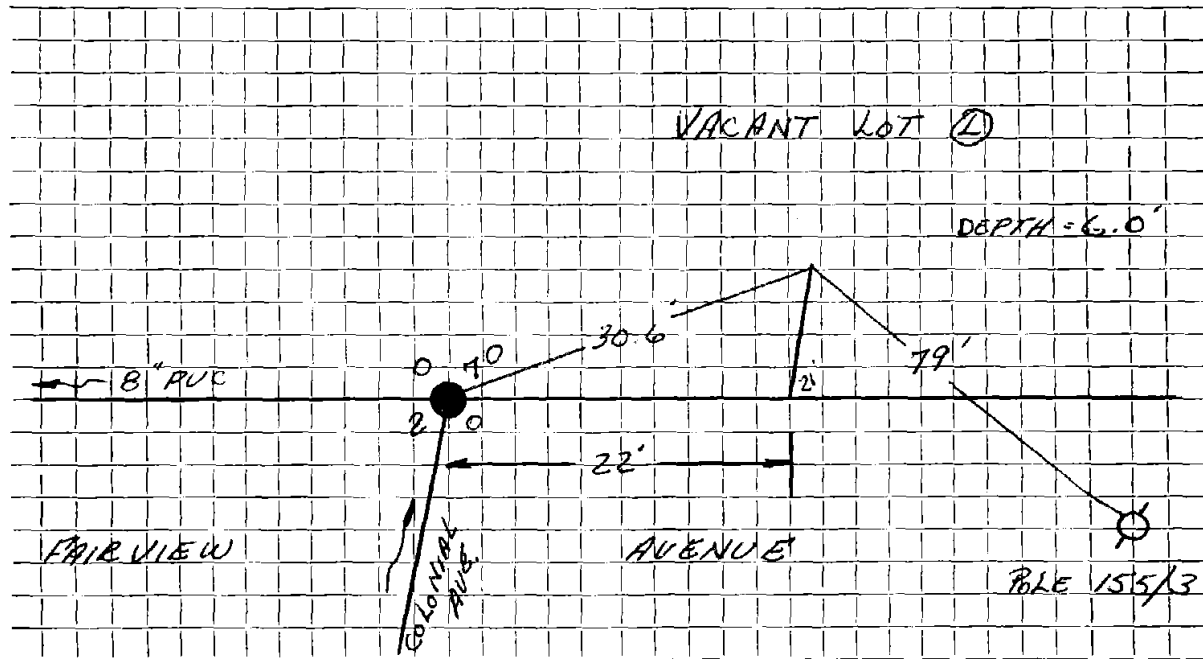

Connection made in FAIR VIEW Street. Work completed Nov. 21, 1980

Remarks: