


DATE _____

TOWN OF LEXINGTON — BOARD OF PUBLIC WORKS
SEWER DIVISION

Sketch of Service Here **4**

LOT #1

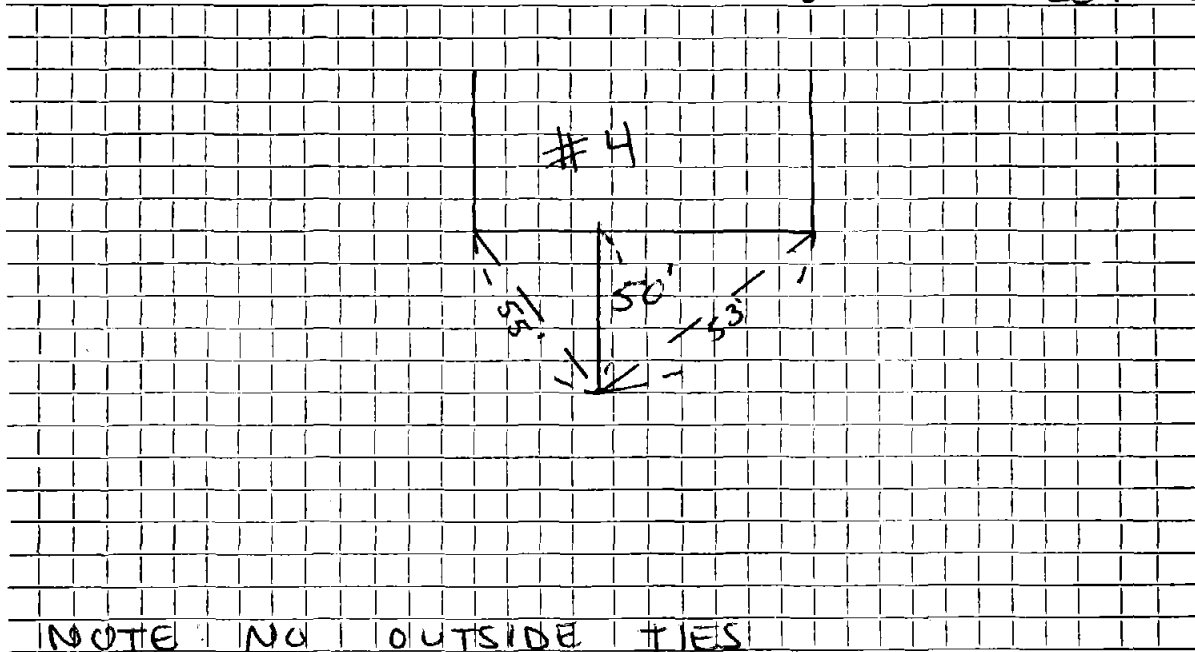

Connection made in FARM RD Street. Work completed

Remarks:
.....
.....