


DATE _____

TOWN OF LEXINGTON — BOARD OF PUBLIC WORKS
SEWER DIVISION

Sketch of Service Here **6**

LOT #2

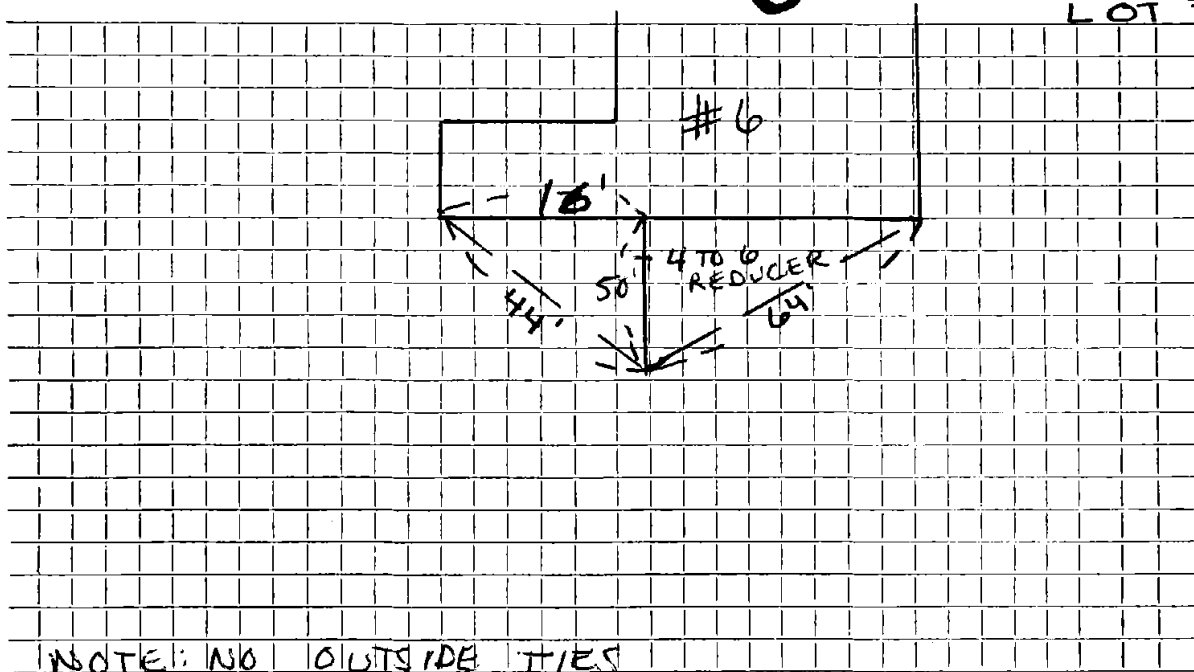

Connection made in FARM RD. Street. Work completed

Remarks:
.....
.....