

Name

Service No.

CRG

Address

8 FARM RD LOT #3

Location

Kind of Pipe

PVC

Size

6"

Size of Main

8"

Repair—Renewal—

(New Service)

Location

Date

Material

Amount

Total

Date

Amount

3/1 88

78' of 6" PVC
(2) 22 1/2° BENDS


DATE _____

TOWN OF LEXINGTON — BOARD OF PUBLIC WORKS
SEWER DIVISION

Sketch of Service Here

8

LOT #23

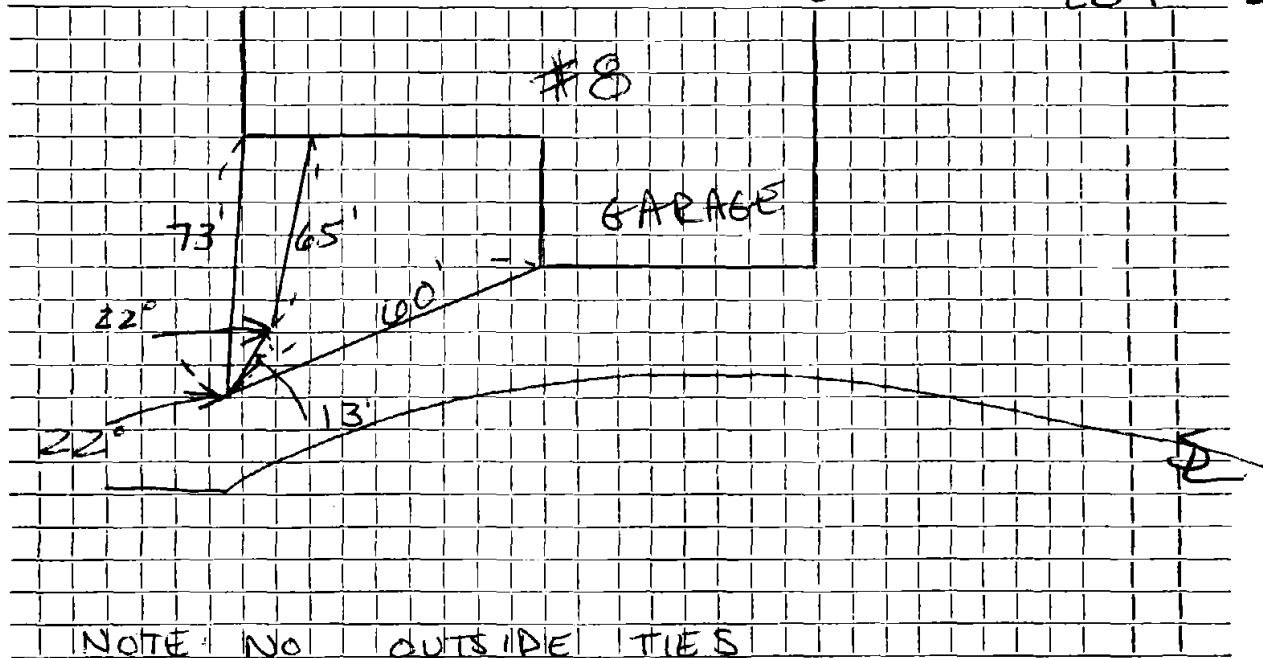

Connection made in FARM RD. Street. Work completed

Remarks:

.....